


North

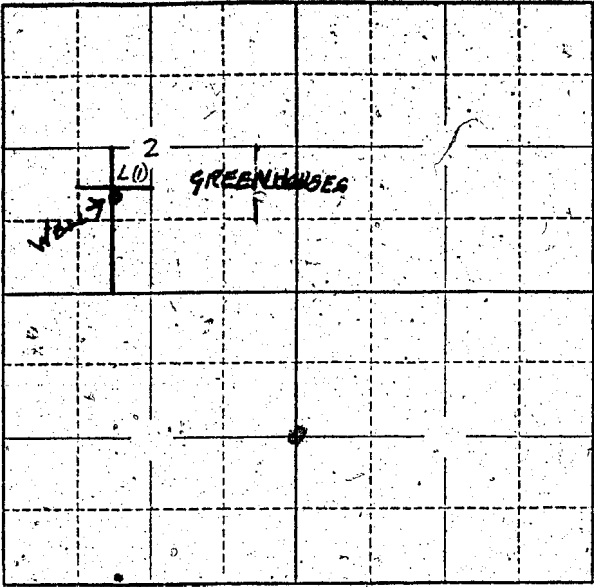

Locate well and acreage of irrigated land on plat.

Scale: 2" = 1 Mile

STATE OF OREGON

County of Multnomah

ss.

I, J. Peterkort, being first duly sworn, do hereby certify that I have read the foregoing Registration Statement and that all of the items therein contained are true to the best of my knowledge and belief. I am President of the registering corporation.

J. Peterkort (Signature of Registrant)

Subscribed and sworn to before me this 11 day of October, 1957

My commission expires May 1, 1960

(Notary Public) Notary Public for Oregon

(SEAL)

CERTIFICATE OF REGISTRATION

STATE OF OREGON

County of Marion

ss.

This is to certify that the foregoing Registration Statement was received in the office of the State Engineer on the 7 day of January, 1958, at 8:00 o'clock AM and has been duly recorded in said office in Book No. 5 of Registration Statements on page 835

Witness my hand this 5 day of March, 1958

Lewis A. Stanley (State Engineer)

By (Deputy)