Township 10 S Range 3 W, W.M.

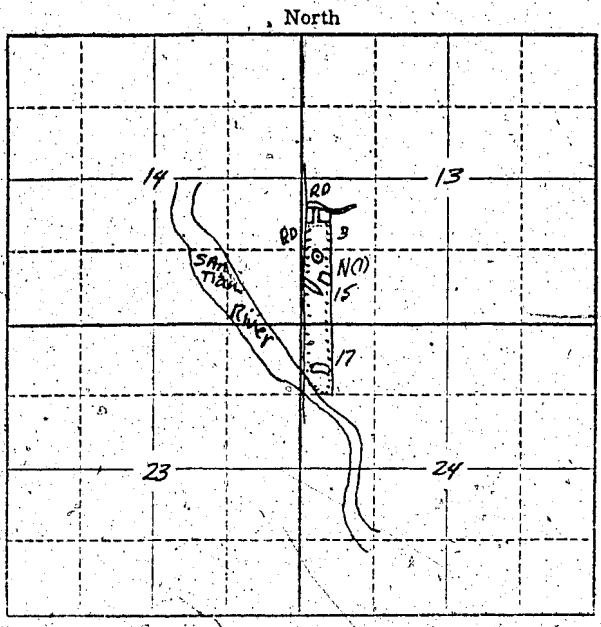

Locate well and acreage of irrigated land on plat.

Scale: 2" = 1 Mile

STATE OF OREGON }
County of Marion Co. } ss.

I, ..., being first duly sworn, do hereby certify that I have read the foregoing Registration Statement and that all of the items therein contained are true to the best of my knowledge and belief.

.....
(Signature of Registrant)

Subscribed and sworn to before me this 7th day of January, 1958.

My commission expires June 12th 1961 .....
Wm. S. Bartholomew
(Notary Public)

(SEAL)

CERTIFICATE OF REGISTRATION

STATE OF OREGON }
County of Marion } ss.

This is to certify that the foregoing Registration Statement was received in the office of the State Engineer on the 7th day of January, 1958, at 11:30 o'clock A. M. and has been duly recorded in said office in Book No. 5 of Registration Statements on page 837

~~Construction shall be completed by x-x-x-x-x-x-x-x-x-19xx-x, and the water completely applied to beneficial use by x-x-x-x-x-x-x-x-x-19xx-x-x~~

Witness my hand this 5 day of March, 1958

Lewis A. Stanley
(State Engineer)

15.25

By .....
(Deputy)

GR-837 C