


North

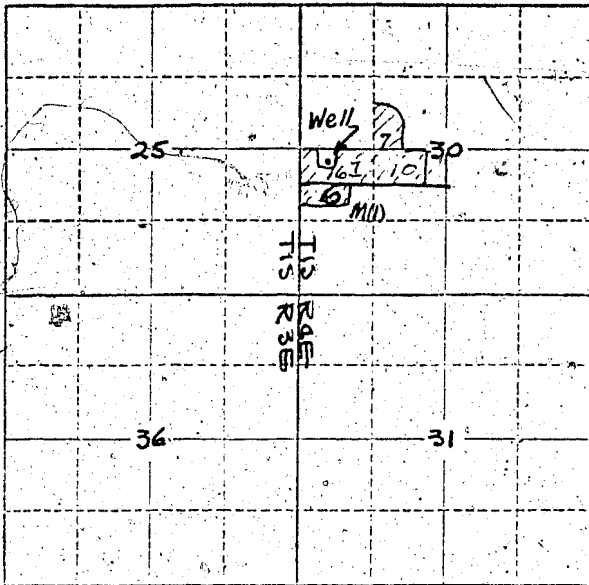

Locate well and acreage of irrigated land on plat.

Scale: 2" = 1 Mile

STATE OF OREGON

County of Multnomah } ss.

I, Josh O'Brien, being first duly sworn, do hereby certify that I have read the foregoing Registration Statement and that all of the items therein contained are true to the best of my knowledge and belief.

(Signature of Registrant)

Subscribed and sworn to before me this 2nd day of March, 1958.

My commission expires March 1958 (Notary Public)

(SEAL)

CERTIFICATE OF REGISTRATION

STATE OF OREGON

County of Marion } ss.

This is to certify that the foregoing Registration Statement was received in the office of the State Engineer on the 8 day of January, 1958, at 8:00 o'clock A.M. and has been duly recorded in said office in Book No. 5 of Registration Statements on page 838.

~~Construction shall be completed by 12:00 and the water completely applied to beneficial use by 12:00.~~

Witness my hand this 5 day of March, 1958.

(State Engineer)

By Lewis A. Stanley (Deputy)

GR 833 C

\$16.50