


North

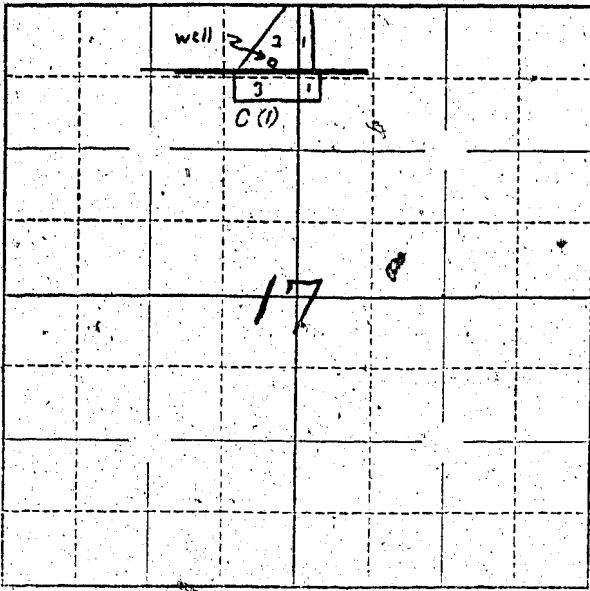

Locate well and acreage of irrigated land on plat.

Scale:  $\frac{1}{4}$ " = 1 Mile

STATE OF OREGON

County of Marion } ss.

I, W. L. Jones, being first duly sworn, do hereby certify that I have read the foregoing Registration Statement and that all of the items therein contained are true to the best of my knowledge and belief.

x W. L. Jones  
(Signature of Registrant)

Subscribed and sworn to before me this 5th day of December, 1957

My commission expires March 18, 1959 Harold A. Eckhardt  
(Notary Public for Oregon)

(SEAL)

**CERTIFICATE OF REGISTRATION**

STATE OF OREGON }  
County of Marion } ss.

This is to certify that the foregoing Registration Statement was received in the office of the State Engineer on the 8 day of January, 1958, at 8:00 o'clock A. M. and has been duly recorded in said office in Book No. 5 of Registration Statements on page 841

~~Construction shall be completed by \_\_\_\_\_ and the water complete for \_\_\_\_\_~~  
~~and shall be used by \_\_\_\_\_~~

Witness my hand this 5 day of March, 1958

Lewis A. Stanley  
(State Engineer)

By \_\_\_\_\_  
(Deputy) GR-841 C