


Township 9S Range 1W W.M.

North

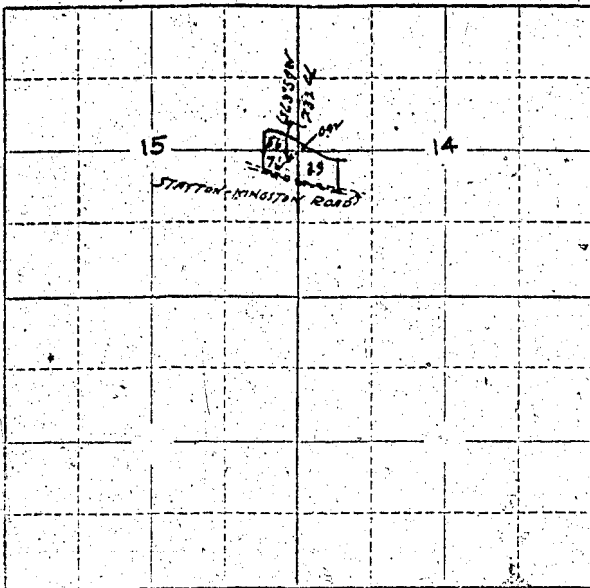

Locate well and acreage of irrigated land on plat.

Scale: 2" = 1 Mile

STATE OF OREGON

County of Marion

ss.

I, John Ferry, being first duly sworn, do hereby certify that I have read the foregoing Registration Statement and that all of the items therein contained are true to the best of my knowledge and belief.

John Ferry
(Signature of Registrant)

Subscribed and sworn to before me this 10th day of January, 1958

My commission expires

NOTARY PUBLIC FOR OREGON
MY COMMISSION EXPIRES SEPT. 12, 1961

(Notary Public)

(SEAL)

CERTIFICATE OF REGISTRATION

STATE OF OREGON

County of Marion

ss.

This is to certify that the foregoing Registration Statement was received in the office of the State Engineer on the 10 day of January, 1958, at 8:00 o'clock A. M. and has been duly recorded in said office in Book No. 5 of Registration Statements on page 812

Construction shall be completed by 1958 and the water completely applied to

confined to by 1958

Witness my hand this 5 day of March, 1958

Lewis A. Stanley
(State Engineer)

By

(Deputy)

GR-842 C