


Township 6 S Range 3 W W.M.  
North

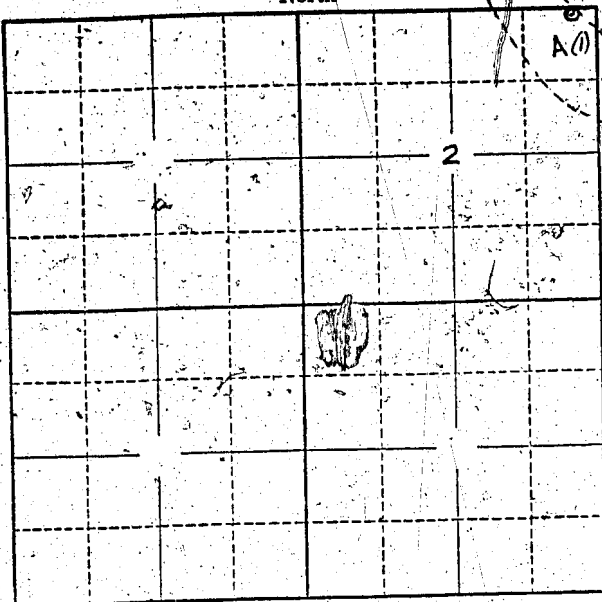

Locate well and acreage of irrigated land on plat.

Scale: 2" = 1 Mile

STATE OF OREGON

County of Marion

} ss.

I, Joe Ryan, being first duly sworn, do hereby certify that I have read the foregoing Registration Statement and that all of the items therein contained are true to the best of my knowledge and belief.

Joe Ryan  
(Signature of Registrant)

Subscribed and sworn to before me this 13th day of January, 1958

[Signature]  
(Notary Public)

My commission expires May 10, 1959

(SEAL)

**CERTIFICATE OF REGISTRATION**

STATE OF OREGON

County of Marion

} ss.

This is to certify that the foregoing Registration Statement was received in the office of the State Engineer on the 13 day of January, 1958, at 6:00 o'clock A.M. and has been duly recorded in said office in Book No. 5 of Registration Statements on page 817.

Witness my hand this 24 day of April, 1958.

Lewis A. Stanley  
(State Engineer)

By \_\_\_\_\_ (Deputy)