Township 17 S Range 3W, W.M.

North

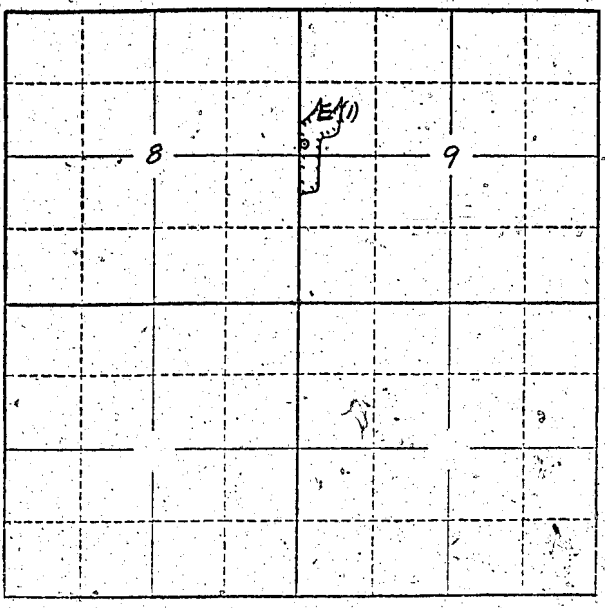

Locate well and acreage of irrigated land on plat.

Scale: 2" = 1 Mile

STATE OF OREGON
County of Lane } ss.

I, Vernon S. Johnson, being first duly sworn, do hereby certify that I have read the foregoing Registration Statement and that all of the items therein contained are true to the best of my knowledge and belief.

[illegible]
(Signature of Registrant)

Subscribed and sworn to before me this 10th day of [illegible], 19[illegible]

My commission expires 3-13-61 [illegible]
(Notary Public)

(SEAL)

CERTIFICATE OF REGISTRATION

STATE OF OREGON
County of Marion } ss.

This is to certify that the foregoing Registration Statement was received in the office of the State Engineer on the 14th day of January, 19[illegible], at [illegible] o'clock [illegible] M. and has been duly recorded in said office in Book No. 5 of Registration Statements on page 849

~~Construction shall be completed by x-x-x-x-x-x-x-x-x-x-x-19x-x-x and the water completely applied to x beneficial use by x-x-x-x-x-x-x-x-x-x-x-19x-x-xx~~

Witness my hand this 24 day of April, 1958.

[illegible]
(State Engineer)

$15.00

By [illegible]
(Deputy)

GR-849 C