

Ellen and Gregory Wilt

7908 Boedigheimer Road SE, Sublimity, OR 97385

Request: change point of appropriation

From:

(A) Registration #GR881/Certificate#GR855, 122.773, 44.839 DD, located off subject property (location notated on maps below with an oval marked "A")

To:

(B) Domestic well on subject property 122.773, 44.841 DD (location notated on maps below with an oval marked "B")

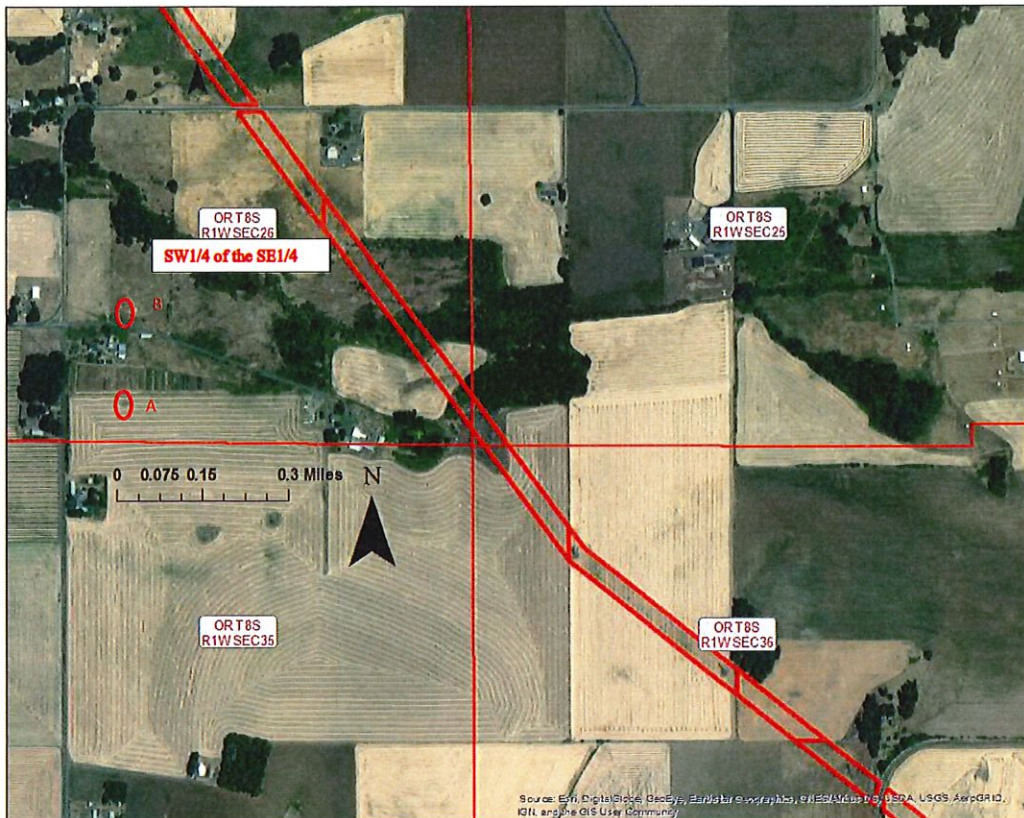


Figure 1. Overview of Wells A (current) and B proposed

Received by OWRD

NOV 09 2019

Salem, OR



Figure 2. Expanded View of Wells A (current) and B proposed

Received by OWRD

NOV 09 2019

Salem, OR


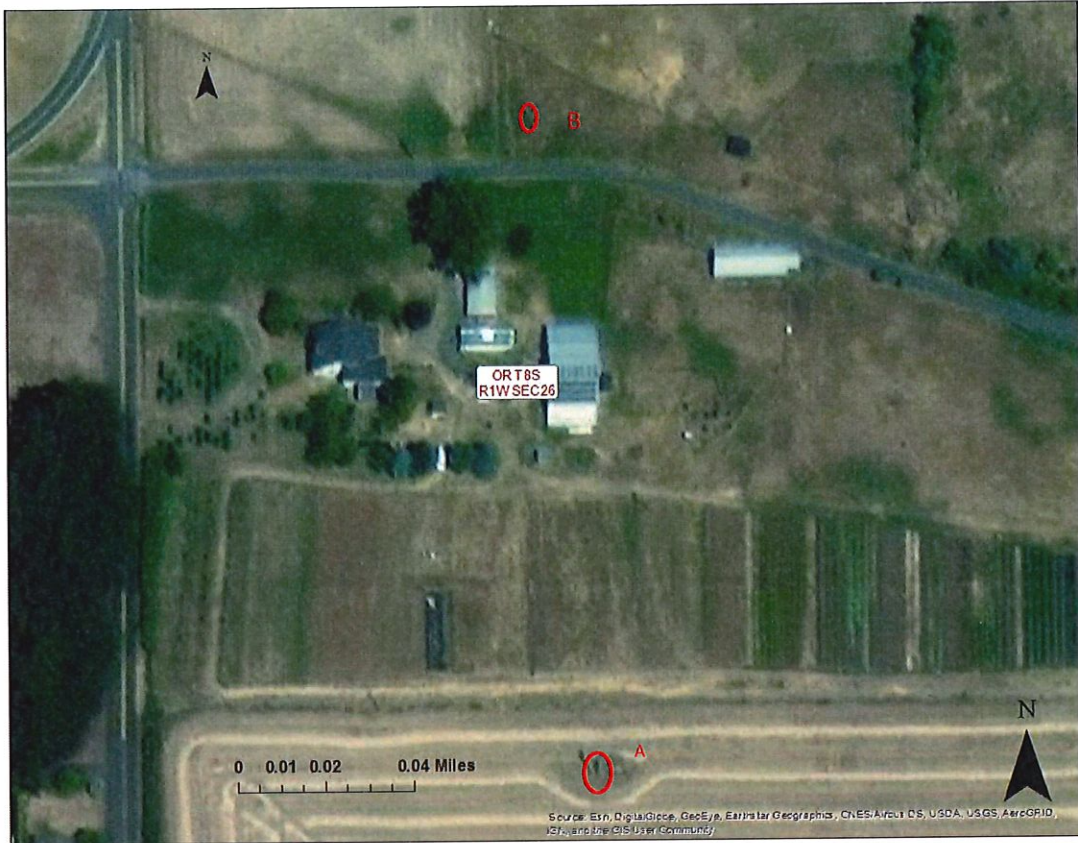


Figure 3. Close-up of Wells A (current) and B proposed

As per GR-881, this proposal is to change point of appropriation for all assigned irrigation acres overlaying tax lot 1200 (all within Section 26) = 40 (of 42) acres of the SW¼ of the SE ¼, 4 (of 4.3) acres in the NE¼ of the SE¼, 7.7 acres in the SE¼ of the SE¼ for a total of 51.7 irrigation acres.


- 14.5 acres
- 19.4 acres
- 8.1 acres
- 42 acres within SW/SE Section 26
- 4.3 acres within NE/SE Section 26
- 7.7 acres within SE/SE Section 26

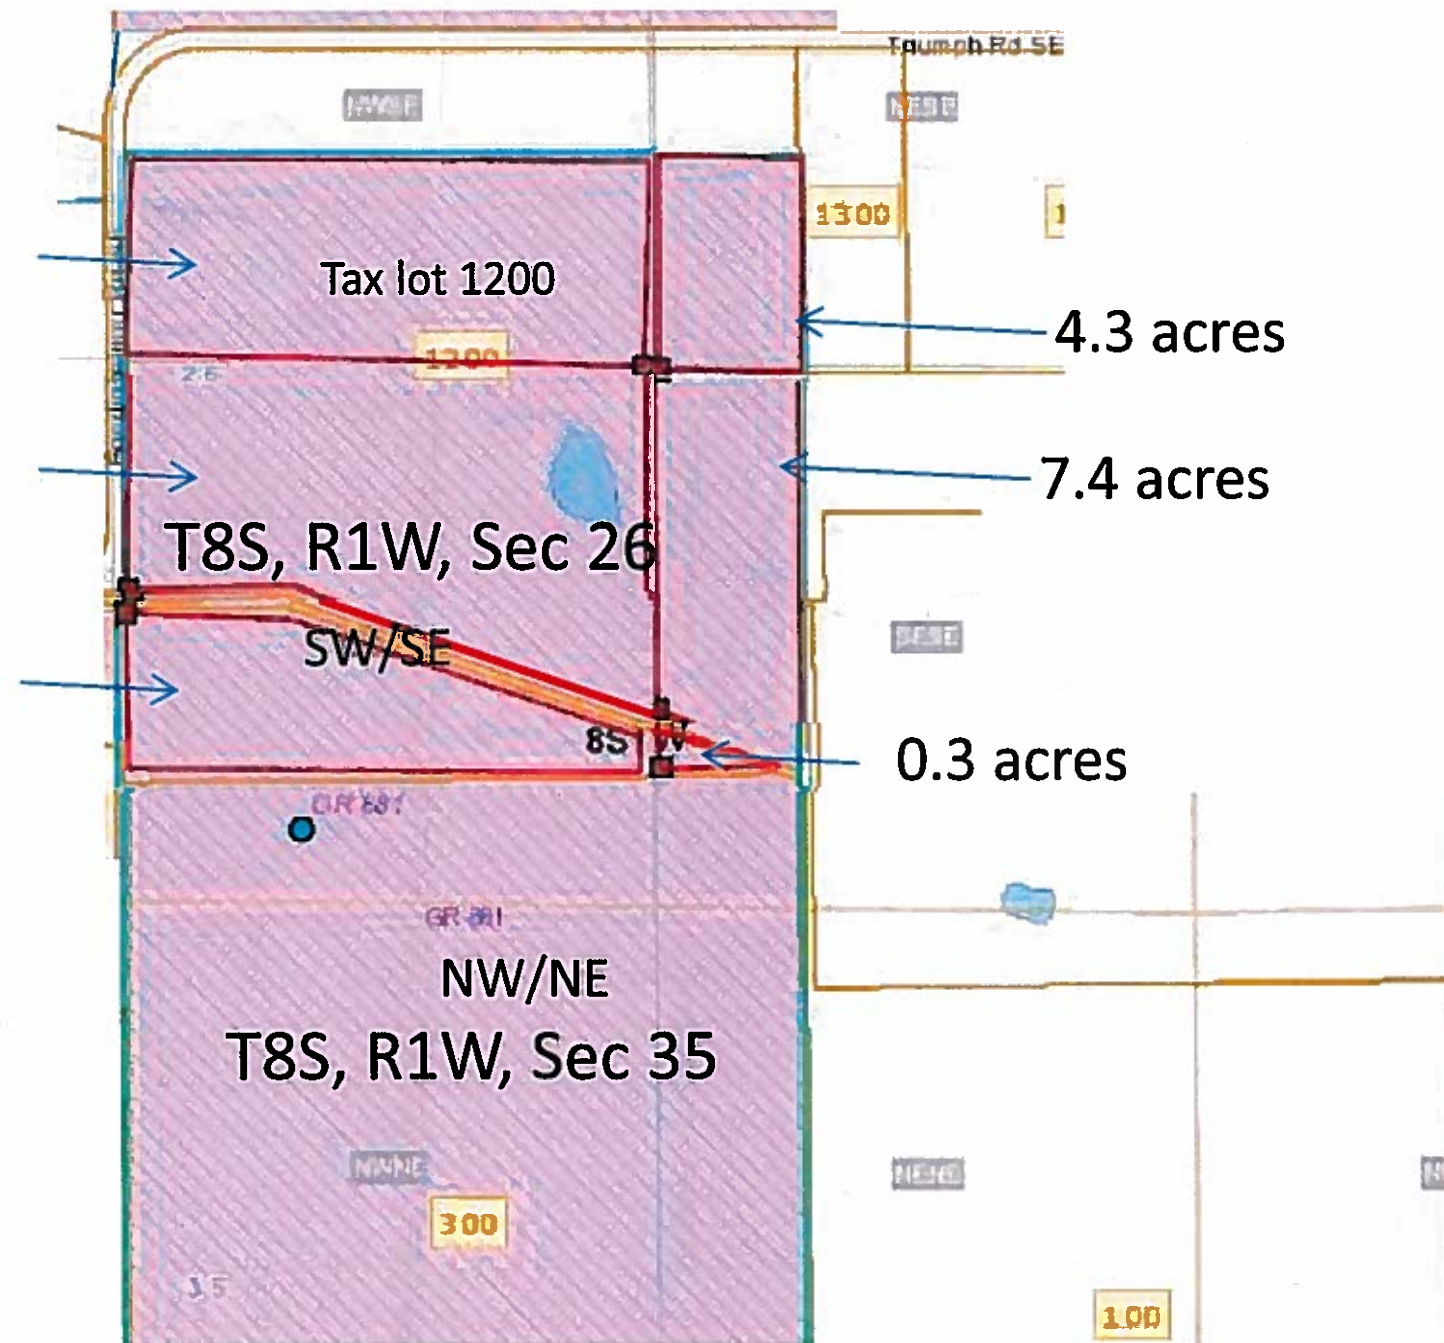

RECEIVED
NOV 29 2018

OWRD
RECEIVED
NOV 14 2018
OWRD

13068

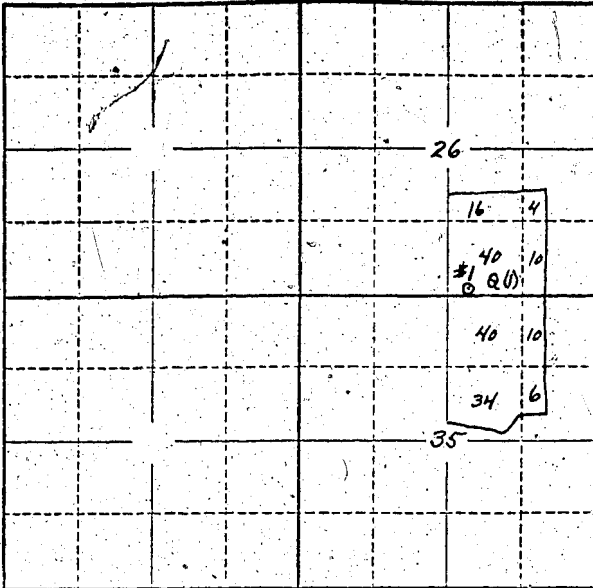

Locate well and acreage of irrigated land on plat.
Scale: 2" = 1 Mile

STATE OF OREGON

County of Marion } ss.

I, Edward J. Miotke, being first duly sworn, do hereby certify that I have read the foregoing Registration Statement and that all of the items therein contained are true to the best of my knowledge and belief.

Edward J. Miotke
(Signature of Registrant)

Subscribed and sworn to before me this 14th day of January, 1958

My commission expires June 12th, 1961

Wm. S. Bartholomew
(Notary Public)

(SEAL)

CERTIFICATE OF REGISTRATION

STATE OF OREGON }
County of Marion } ss.

This is to certify that the foregoing Registration Statement was received in the office of the State Engineer on the 11 day of January, 1958, at 11:00 o'clock A.M. and has been duly recorded in said office in Book No. 5 of Registration Statements on page 855

Witness my hand this 21 day of April, 1958

Wm. S. Bartholomew
(State Engineer)

By _____
(Deputy)