


Township 55 Range 3 W W.M.
North

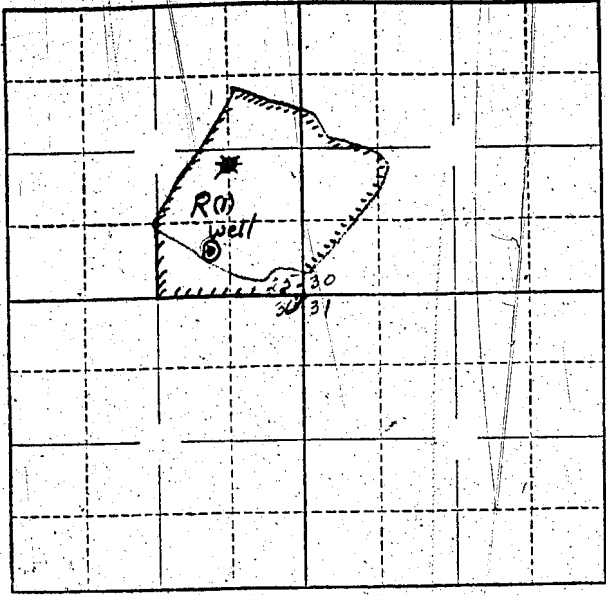

Locate well and acreage of irrigated land on plat.
Scale: 2" = 1 Mile
4"

STATE OF OREGON }
County of Marion } ss.

I, Viola Mae Pearman, being first duly sworn, do hereby certify that I have read the foregoing Registration Statement and that all of the items therein contained are true to the best of my knowledge and belief.

Viola Mae Pearman
(Signature of Registrant)

Subscribed and sworn to before me this 19th day of January, 1958.

My commission expires June 12th 1961 Wm. S. Beathelmeier
(Notary Public)

(SEAL)

CERTIFICATE OF REGISTRATION

STATE OF OREGON }
County of Marion } ss.

This is to certify that the foregoing Registration Statement was received in the office of the State Engineer on the 11 day of January, 1958, at 12 o'clock PM and has been duly recorded in said office in Book No. 25 of Registration Statements on page 558.

Witness my hand this 24 day of April, 1958.

Lewis A. Anderson
(State Engineer)

By _____ (Deputy)