*See Map in file GR-885*

Township ....*7S*.... Range ....*3W*.... W.M.

North

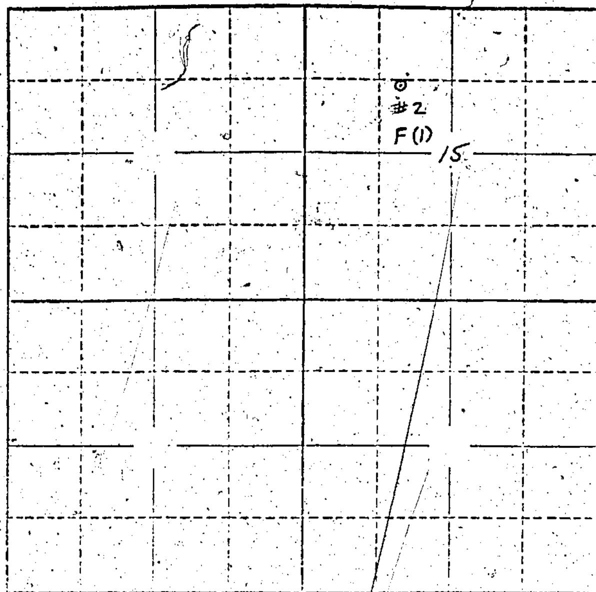


Locate well and acreage of irrigated land on plat.

Scale: 2" = 1 Mile

STATE OF OREGON }
County of ....*Marion*.... } ss.

I, ........................................, being first duly sworn, do hereby certify that I have read the foregoing Registration Statement and that all of the items therein contained are true to the best of my knowledge and belief.

*Lena May Carpenter*
(Signature of Registrant)

Subscribed and sworn to before me this *15th* day of *January* 19*55*

My commission expires *June 12th, 1961* ....*Wm. S. Bartholomew*....
(Notary Public)

(SEAL)

**CERTIFICATE OF REGISTRATION**

STATE OF OREGON }
County of Marion } ss.

This is to certify that the foregoing Registration Statement was received in the office of the State Engineer on the [illegible] day of [illegible], 19[illegible], at [illegible] o'clock [illegible] M. and has been duly recorded in said office in Book No. ....5.... of Registration Statements on page ....[illegible]62....

x-x-x-x-x-x-x-x-x-x-x-x-x-x-x-x-x-x-x-x-x-x-19x-x-x-x-x-x-x-x-x-x-x-x-x-x-x-x-x
x-x-x-x-x-x-x-x-x-x-x-x-x-x-x-x-x-19x-x-x-x

Witness my hand this ....24.... day of ....**April**.... 19**58**

*Lewis A. Stanley* [illegible]
(State Engineer)

By ........................................
(Deputy)

*GR-861 C*