


North

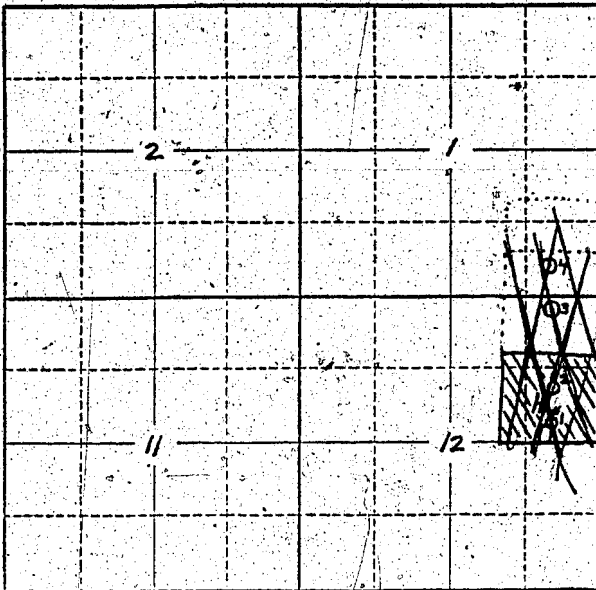

See Map in G-220

Locate well and acreage of irrigated land on plat.

Scale: 2" = 1 Mile

STATE OF OREGON

County of Linn

ss.

I, Leo F. and Beryl G. Michele, being first duly sworn, do hereby certify that I have read the foregoing Registration Statement and that all of the items therein contained are true to the best of my knowledge and belief.

Leo F. Michele
Beryl G. Michele
(Signature of Registrant)

Subscribed and sworn to before me this 19th day of January, 1956.

My commission expires Sept 3, 1957
Ann. Landwehr
(Notary Public)

(SEAL)

CERTIFICATE OF REGISTRATION

STATE OF OREGON

County of Marion

ss.

This is to certify that the foregoing Registration Statement was received in the office of the State Engineer on the 25th day of January, 1956, at 8:00 o'clock A.M. and has been duly recorded in said office in Book No. 1 of Registration Statements on page GR-85C.

Construction shall ^{is} be completed by _____, 1956, and the water ^{is} completely applied to beneficial use by _____, 1956.

Witness my hand this 12th day of April, 1956
Lewis A. Stanley
(State Engineer)

By _____
(Deputy)