


Township Range W.M.
North

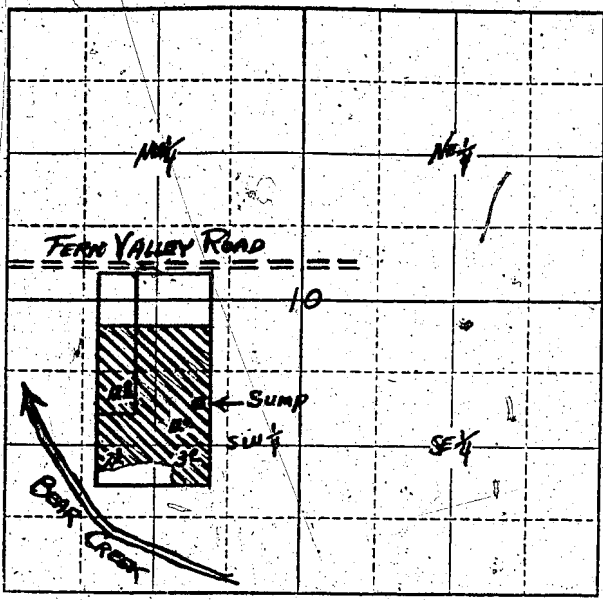

Locate well and acreage of irrigated land on plat.
Scale: $\frac{1}{4}$ = 1 Mile

STATE OF OREGON

County of Clatsop } ss.

I, S. E. Cox & Malen Cox, being first duly sworn, do hereby certify that I have read the foregoing Registration Statement and that all of the items therein contained are true to the best of my knowledge and belief.

[Signature]
(Signature of Registrant)

Subscribed and sworn to before me this 14th day of April, 1956

My commission expires APRIL 1, 1953

[Signature]
(Notary Public)

(SEAL)

CERTIFICATE OF REGISTRATION

STATE OF OREGON } ss.
County of Marion

This is to certify that the foregoing Registration Statement was received in the office of the State Engineer on the 14th day of April, 1956, at 11:00 o'clock AM and has been duly recorded in said office in Book No. 5 of Registration Statements on page 867

Witness my hand this 24 day of April, 1958

[Signature]
(State Engineer)

By
(Deputy)