


Township 10 S. Range 2 W., W.M.  
North

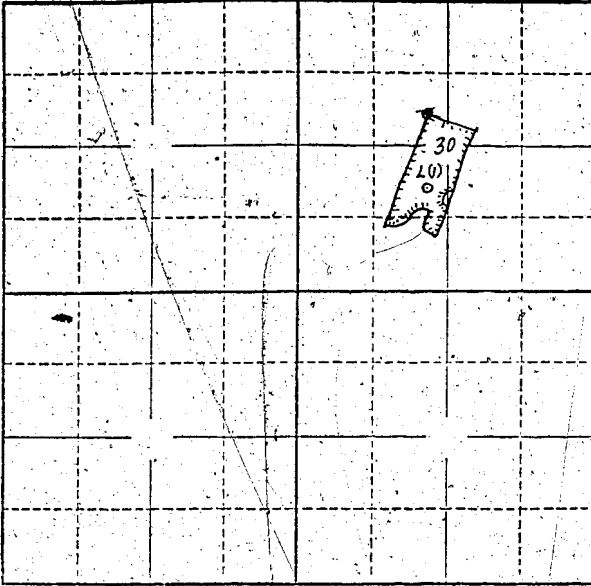

Locate well and acreage of irrigated land on plat.  
Scale: 2" = 1 Mile

STATE OF OREGON

County of Lincoln } ss.

I, Edna C. Baker, being first duly sworn, do hereby certify that I have read the foregoing Registration Statement and that all of the items therein contained are true to the best of my knowledge and belief.

Edna C. Baker  
(Signature of Registrant)

Subscribed and sworn to before me this 24 day of April, 1958.

My commission expires 1959

(Notary Public)

(SEAL)

**CERTIFICATE OF REGISTRATION**

STATE OF OREGON

County of Marion } ss.

This is to certify that the foregoing Registration Statement was received in the office of the State Engineer on the 24 day of April, 1958, at 10 o'clock AM and has been duly recorded in said office in Book No. 5 of Registration Statements on page 875.

Witness my hand this 24 day of April, 1958.

W. W. ...  
(State Engineer)

By \_\_\_\_\_ (Deputy)