


Township 6 S Range 3 W, W.M.
North

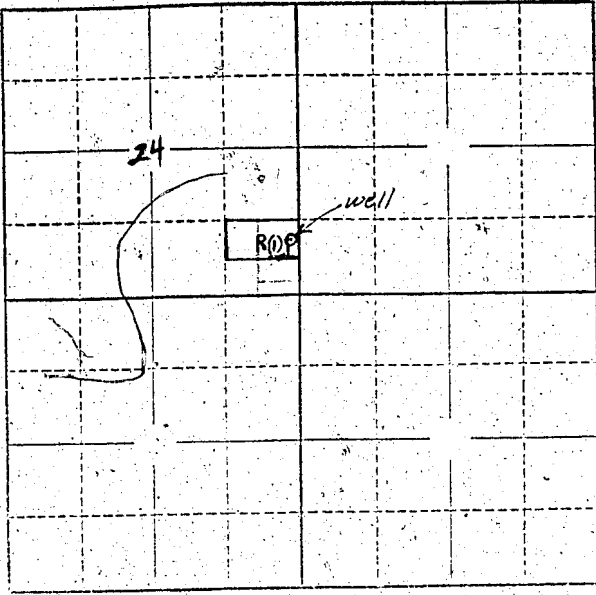

The North 1/2 of the
S.E. 1/4 of the SE 1/4
of Section 24
Township 6 South
Range 3 West of
Willamette Meridian
Marion County, Oreg.

Locate well and acreage of irrigated land on plat.
Scale: 2" = 1 Mile

STATE OF OREGON }
County of MARION } ss.

I, Fred Wymore, being first duly sworn, do hereby certify that I have read the foregoing Registration Statement and that all of the items therein contained are true to the best of my knowledge and belief.

Fred Wymore
(Signature of Registrant)

Subscribed and sworn to before me this 15 day of JANUARY, 1958

My commission expires March 18, 1959 Harold A. Eitzen
(Notary Public)

(SEAL)

CERTIFICATE OF REGISTRATION

STATE OF OREGON }
County of Marion } ss.

This is to certify that the foregoing Registration Statement was received in the office of the State Engineer on the 22 day of January, 1958, at 8:00 o'clock A.M. and has been duly recorded in said office in Book No. 5 of Registration Statements on page 890

~~Construction shall be complete by X-X-X-X-X-X-X-X-X-X-X-X-X-X-X-X and the water completely applied to benefit X-X-X-X-X-X-X-X-X-X-X-X-X-X-X-X~~

Witness my hand this 7 day of May, 19 58

[Signature]
(State Engineer)

By _____
(Deputy)

GR-307C