


North

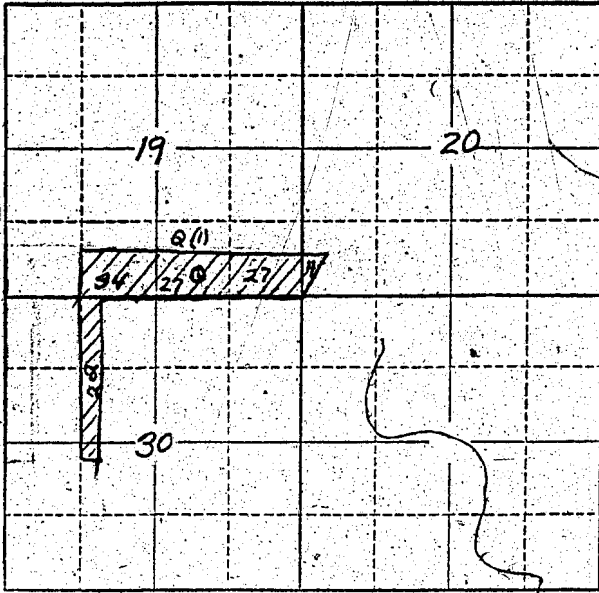

Locate well and acreage of irrigated land on plat.

Scale: 2" = 1 Mile

STATE OF OREGON

County of Marion

SS.

I, Florence Nancy Lucas, being first duly sworn, do hereby certify that I have read the foregoing Registration Statement and that all of the items therein contained are true to the best of my knowledge and belief.

\*Dr. Jewell Lucas Florence Nancy Lucas  
by Florence Nancy Lucas  
(Signature of Registrant)

Subscribed and sworn to before me this 30 day of January, 1956

My commission expires 9/27/58

Jeanie Baxter  
(Notary Public)

(SEAL)

**CERTIFICATE OF REGISTRATION**

STATE OF OREGON

County of Marion

SS.

This is to certify that the foregoing Registration Statement was received in the office of the State Engineer on the 30 day of January, 1956, at 2:00 o'clock P.M. and has been duly recorded in said office in Book No. 1 of Registration Statements on page GR-88C.

Construction shall be completed by 15 15, 1956, and the water completely applied to beneficial use by 19.

Witness my hand this 12th day of April, 1956.

Levio A. Stanley  
(State Engineer)

By

(Deputy)

G.R. - 88 C