


North

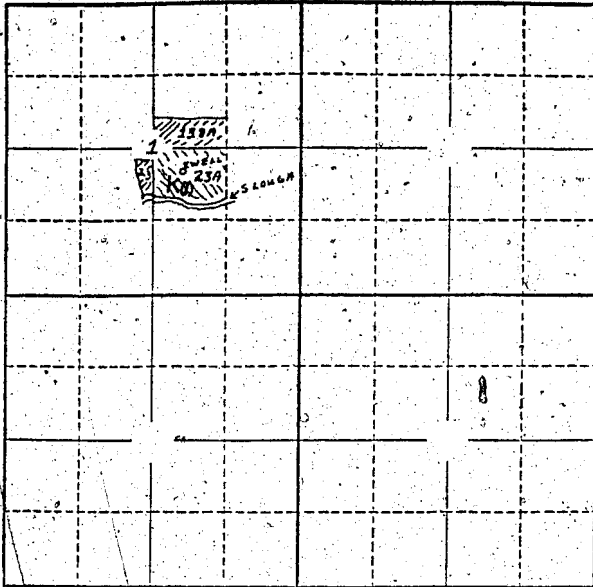

Locate well and acreage of irrigated land on plat.

Scale: 2" = 1 Mile

STATE OF OREGON

County of Lake } ss.

I, Lewis B. McBee, being first duly sworn, do hereby certify that I have read the foregoing Registration Statement and that all of the items therein contained are true to the best of my knowledge and belief.

Lewis B. McBee (Signature of Registrant)

Subscribed and sworn to before me this 20th day of January, 1958

My Commission Expires February 1, 1961

My commission expires

[Signature of Notary Public]

(Notary Public)

(SEAL)

CERTIFICATE OF REGISTRATION

STATE OF OREGON } ss. County of Marion

This is to certify that the foregoing Registration Statement was received in the office of the State Engineer on the 20th day of January, 1958, at 10:00 o'clock A.M. and has been duly recorded in said office in Book No. 5 of Registration Statements on page 896.

Witness my hand this 7th day of May, 1958

Laura A. [Signature] (State Engineer)

By [Signature] (Deputy)