


SECTION

TOWNSHIP 55, RANGE 24, W. M.

North

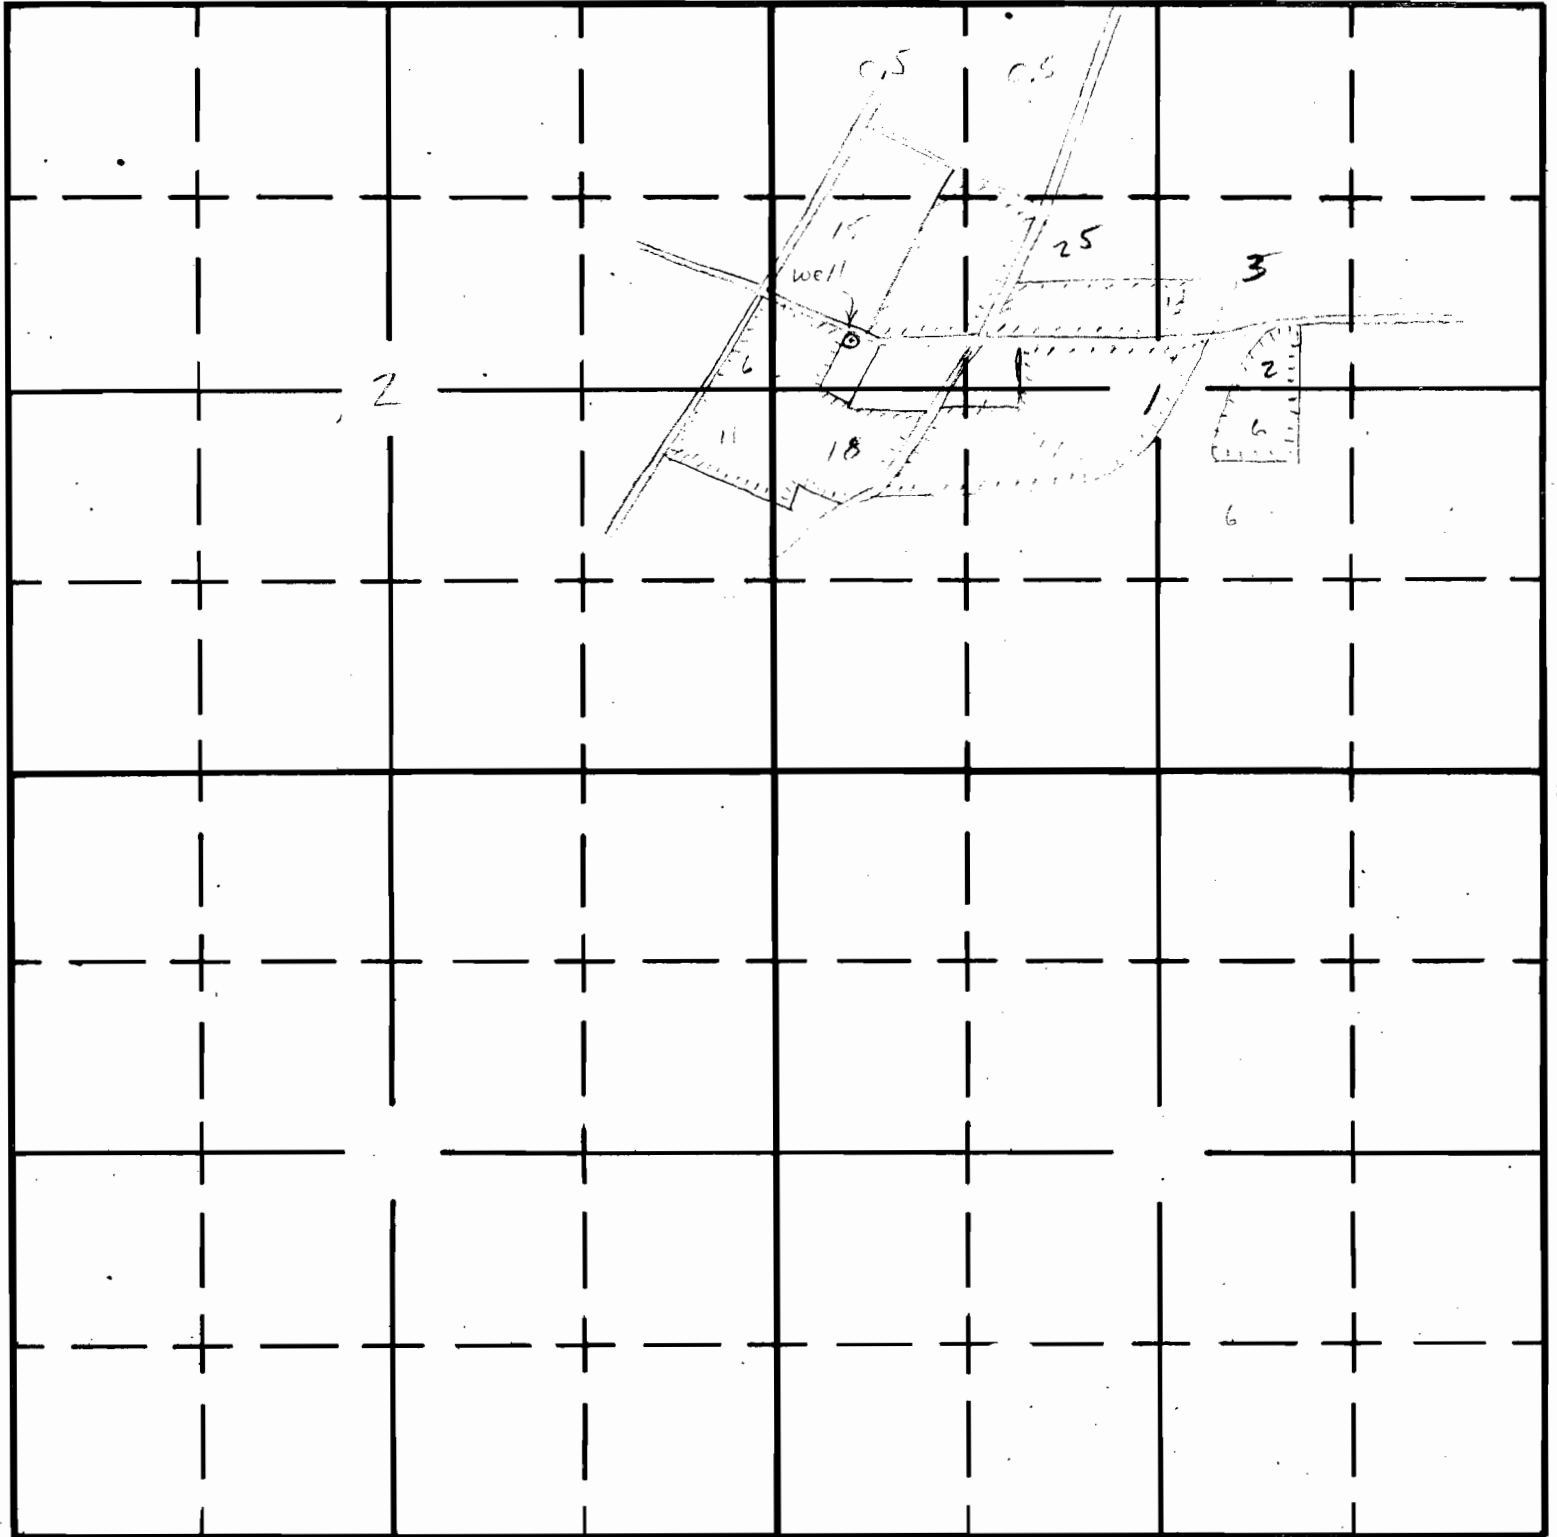

South

West

East