


North

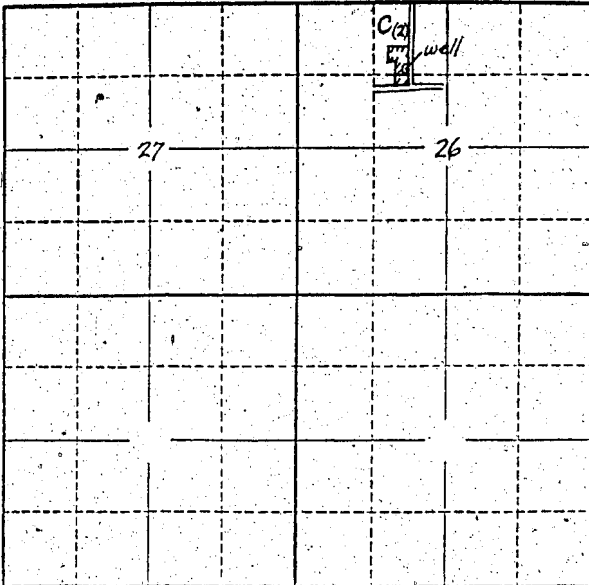

Locate well and acreage of irrigated land on plat.

Scale: 2" = 1 Mile

STATE OF OREGON

County of Linn } ss.

I, Curtis J. and Thelma M. Spiree, being first duly sworn, do hereby certify that I have read the foregoing Registration Statement and that all of the items therein contained are true to the best of my knowledge and belief.

[Signature]  
(Signature of Registrant)

Subscribed and sworn to before me this 20th day of April, 1954

My commission expires 11th 10 1961  
(Notary Public)

(SEAL)

**CERTIFICATE OF REGISTRATION**

STATE OF OREGON } ss.  
County of Marion

This is to certify that the foregoing Registration Statement was received in the office of the State Engineer on the 27th day of January, 1954, at 2:00 o'clock P.M. and has been duly recorded in said office in Book No. 5 of Registration Statements on page 204

Witness my hand this 7 day of May, 1953

[Signature]  
(State Engineer)

By \_\_\_\_\_  
(Deputy)