


Township 37 S Range 2 W, W.M.

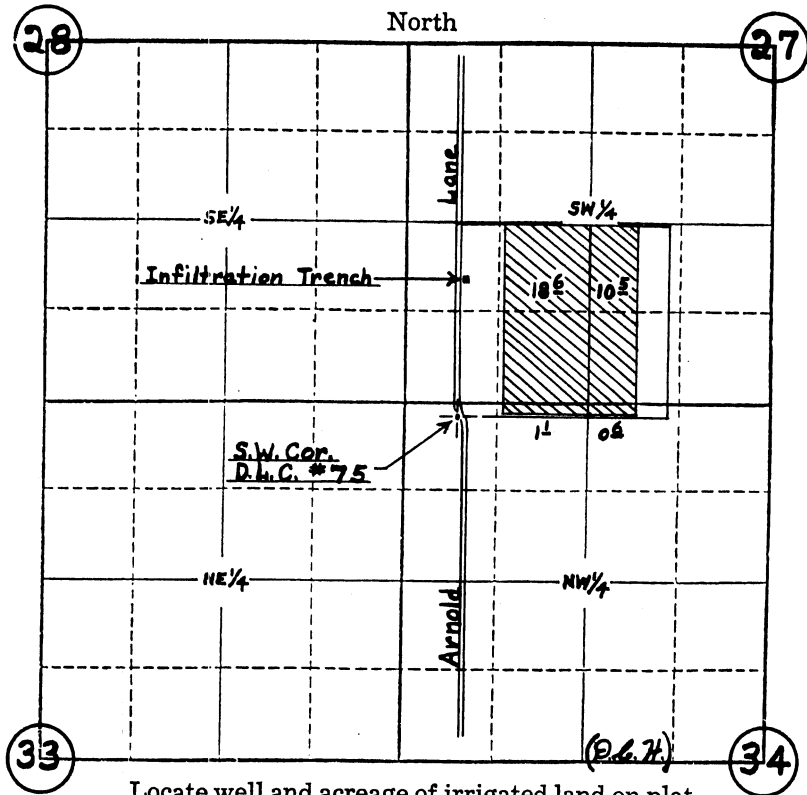

Locate well and acreage of irrigated land on plat.

Scale: 4" = 1 Mile

STATE OF OREGON

County of Jackson } ss.

I, H. A. Brunckley, being first duly sworn, do hereby certify that I have read the foregoing Registration Statement and that all of the items therein contained are true to the best of my knowledge and belief.

H. A. Brunckley  
(Signature of Registrant)

Subscribed and sworn to before me this 24th day of January, 1958

My commission expires Nov. 23-1960

By [Signature]  
(Notary Public)

(SEAL)

**CERTIFICATE OF REGISTRATION**

STATE OF OREGON } ss.  
County of Marion

This is to certify that the foregoing Registration Statement was received in the office of the State Engineer on the 27th day of January, 1958, at 8:00 o'clock A.M. and has been duly recorded in said office in Book No. 5 of Registration Statements on page 907.

Witness my hand this 7 day of May, 1958.

[Signature]  
(State Engineer)

\$15.15

By \_\_\_\_\_ (Deputy)