


North

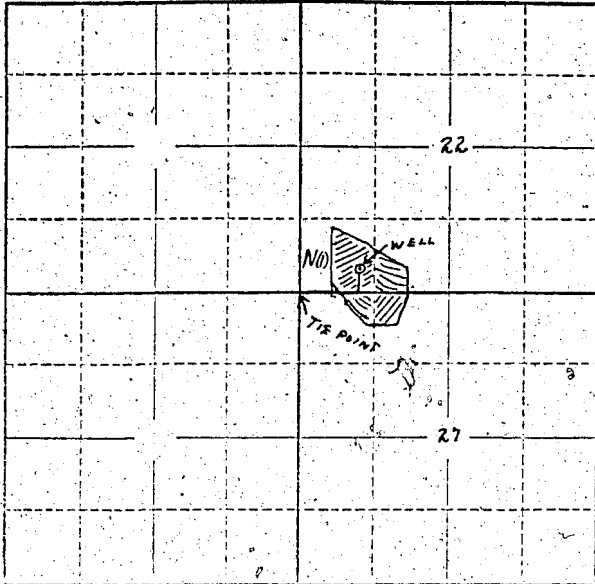

Locate well and acreage of irrigated land on plat.

Scale: 2" = 1 Mile

STATE OF OREGON

County of Lane ss.

I, Leo Stump, being first duly sworn, do hereby certify that I have read the foregoing Registration Statement and that all of the items therein contained are true to the best of my knowledge and belief.

Leo Stump (Signature of Registrant)

Subscribed and sworn to before me this 30th day of January, 1958

My commission expires April 5, 1961 (Notary Public)

(SEAL)

CERTIFICATE OF REGISTRATION

STATE OF OREGON

County of Marion ss.

This is to certify that the foregoing Registration Statement was received in the office of the State Engineer on the 27th day of May, 1958, at ... o'clock ... M. and has been duly recorded in said office in Book No. 5 of Registration Statements on page 909.

Construction shall be completed by ... and the water completely applied to beneficial use by ...

Witness my hand this 7th day of May, 1958

(State Engineer)

By (Deputy)