Township 3S Range 3W W.M.

North

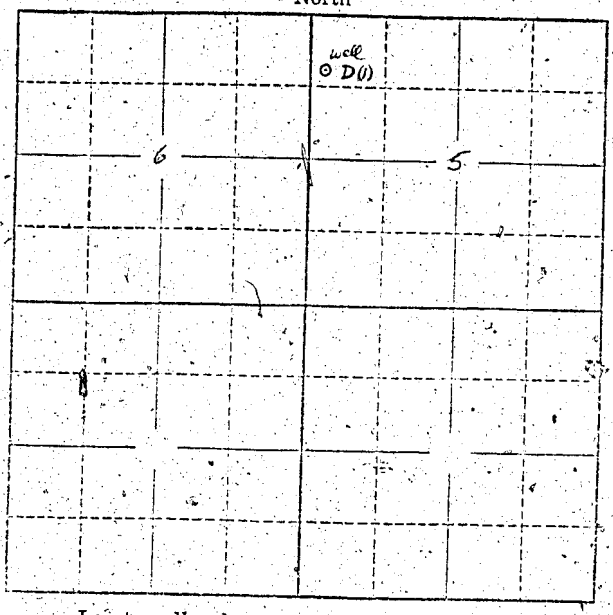


See map in Application 32083

Locate well and acreage of irrigated land on plat.

Scale: 2" = 1 Mile

STATE OF OREGON
County of Marion Co. } ss:

I, ....., being first duly sworn, do hereby certify that I have read the foregoing Registration Statement and that all of the items therein contained are true to the best of my knowledge and belief.

E. R. Baker
(Signature of Registrant)

Subscribed and sworn to before me this 27th day of January, 19 58.

My commission expires 12th June 1961

Wm. D. Bartholomew
(Notary Public)

(SEAL)

**CERTIFICATE OF REGISTRATION**

STATE OF OREGON
County of Marion } ss.

This is to certify that the foregoing Registration Statement was received in the office of the State Engineer on the 27 day of January 1958, at 3:40 o'clock P. M. and has been duly recorded in said office in Book No. 5 of Registration Statements on page 911

~~Construction shall be completed by ..... and the water completely applied to beneficial use by .....~~

Witness my hand this 7 day of May, 19 58.

(State Engineer)

By .....
(Deputy)

GR-911 C