


North

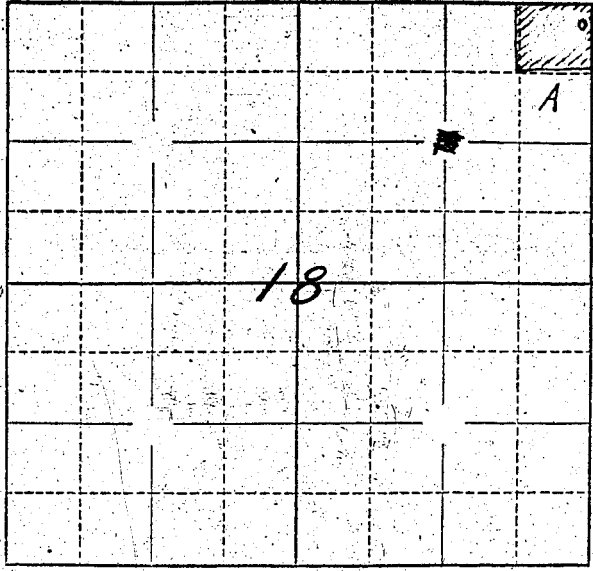

Locate well and acreage of irrigated land on plat.

Scale:  $\frac{1}{4}$ " = 1 Mile

STATE OF OREGON

County of Washington } ss.

I, Rudolph Johnson, being first duly sworn, do hereby certify that I have read the foregoing Registration Statement and that all of the items therein contained are true to the best of my knowledge and belief.

Rudolph Johnson  
(Signature of Registrant)

Subscribed and sworn to before me this 29 day of January, 1958

My commission expires January 16, 1959 Shirley K. Hill  
(Notary Public)

(SEAL)

**CERTIFICATE OF REGISTRATION**

STATE OF OREGON }  
County of Marion } ss.

This is to certify that the foregoing Registration Statement was received in the office of the State Engineer on the 29<sup>th</sup> day of January, 1958, at 0:00 o'clock A. M. and has been duly recorded in said office in Book No. 11 of Registration Statements on page GR-2443

~~Construction shall be completed by 18 and the water completely applied to beneficial uses by 18~~

Witness my hand this 16<sup>th</sup> day of March, 1959

Lewis A. Dittman  
(State Engineer)

\$ 25.00

By \_\_\_\_\_ (Deputy)