


North

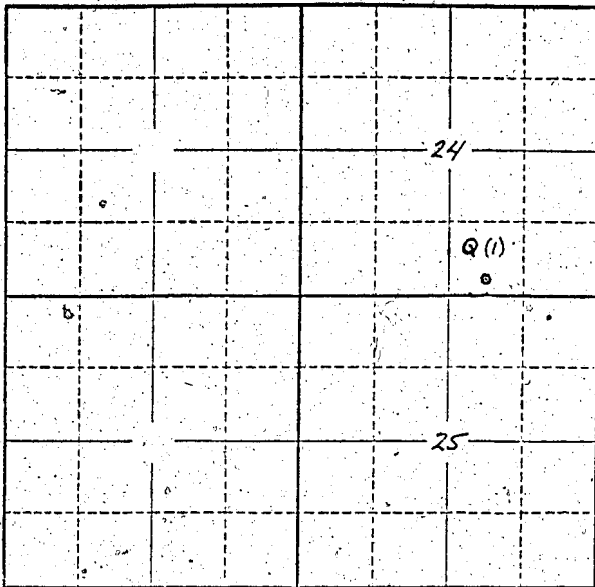

Locate well and acreage of irrigated land on plat.

Scale: 2" = 1 Mile

STATE OF OREGON

County of LINN } ss.

I, George W. and Katie E. Call, being first duly sworn, do hereby certify that I have read the foregoing Registration Statement and that all of the items therein contained are true to the best of my knowledge and belief.

George W. Call
Katie E. Call
(Signature of Registrant)

Subscribed and sworn to before me this 17th day of January, 1958

My commission expires My Commission expires May 21, 1958

(Notary Public)

(SEAL)

CERTIFICATE OF REGISTRATION

STATE OF OREGON

County of Marion } ss.

This is to certify that the foregoing Registration Statement was received, in the office of the State Engineer on the 29th day of January, 1958, at 1:00 o'clock P.M. and has been duly recorded in said office in Book No. 5 of Registration Statements on page 920

Witness my hand this 7th day of May 1958

Claris A. Sturley
(State Engineer)

By (Deputy)