Township 1N Range 1W W.M.

North

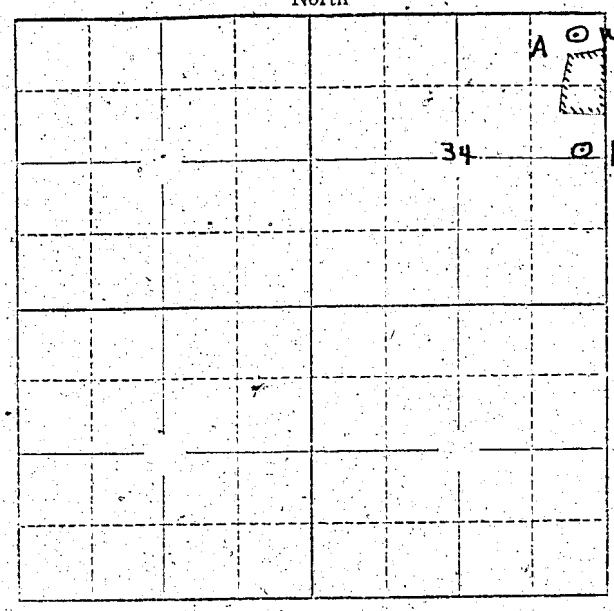

Locate well and acreage of irrigated land on plat.

Scale: 2" = 1 Mile

STATE OF OREGON }
County of Washington } ss.

I, Alfred B Kinzel, being first duly sworn, do hereby certify that I have read the foregoing Registration Statement and that all of the items therein contained are true to the best of my knowledge and belief.

Alfred B Kinzel
(Signature of Registrant)

Subscribed and sworn to before me this 14th day of January, 1958

My commission expires August 27 1958

Dan C Miller
(Notary Public)

(SEAL)

CERTIFICATE OF REGISTRATION

STATE OF OREGON }
County of Marion } ss.

This is to certify that the foregoing Registration Statement was received in the office of the State Engineer on the 20 day of January, 1958, at 8:00 o'clock A.M. and has been duly recorded in said office in Book No. 5 of Registration Statements on page 921

~~Construction shall be completed by X-X-X-X-X-X-X-X-X 19X-X-X and the water to be applied to X-X-X-X-X-X-X-X-