


Township 6S Range 3W W.M.

North

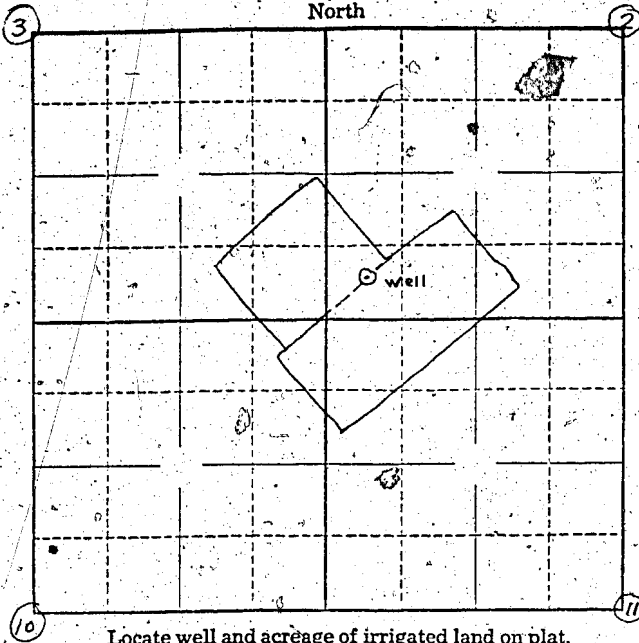

Locate well and acreage of irrigated land on plat.

Scale: $\frac{1}{4}$ = 1 Mile

STATE OF OREGON

County of Marion

ss.

I, _____, being first duly sworn, do hereby certify that I have read the foregoing Registration Statement and that all of the items therein contained are true to the best of my knowledge and belief.

Paul Townsend
(Signature of Registrant)

Subscribed and sworn to before me this 30th day of January, 1958.

My commission expires 12th June 1961

Wm S. Bartholomew
(Notary Public)

(SEAL)

CERTIFICATE OF REGISTRATION

STATE OF OREGON

County of Marion

ss.

This is to certify that the foregoing Registration Statement was received in the office of the State Engineer on the 30 day of January, 1958, at 10:00 o'clock A.M. and has been duly recorded in said office in Book No. 5 of Registration Statements on page 923.

Witness my hand this 7 day of May, 1958

Lewis A. Stanley
(State Engineer)

By _____

(Deputy)

GR - 923 C