


North

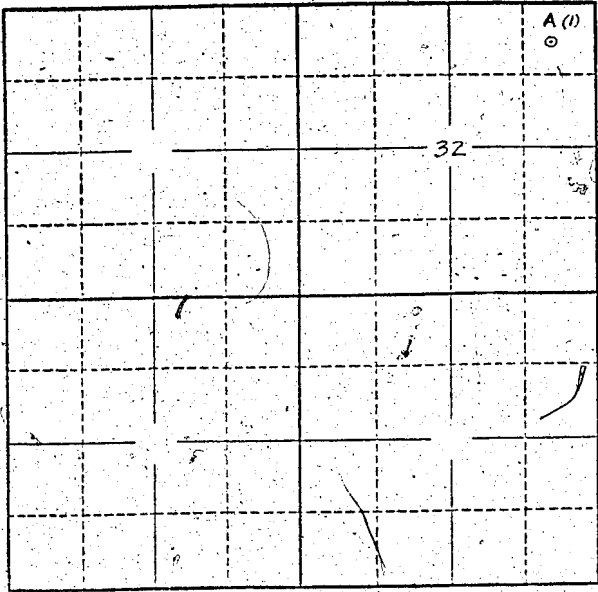

Locate well and acreage of irrigated land on plat.

Scale: 2" = 1 Mile

STATE OF OREGON

County of Latic

ss.

I, Whitaker, being first duly sworn, do hereby certify that I have read the foregoing Registration Statement and that all of the items therein contained are true to the best of my knowledge and belief.

Blay Whitaker  
(Signature of Registrant)

Subscribed and sworn to before me this 3rd day of February, 1958

My commission expires June 12th, 1961

Wm. S. Bartholomew  
(Notary Public)

(SEAL)

**CERTIFICATE OF REGISTRATION**

STATE OF OREGON

County of Marion

ss.

This is to certify that the foregoing Registration Statement was received in the office of the State Engineer on the 3 day of February, 1958, at 8:00 o'clock A.M. and has been duly recorded in said office in Book No. 5 of Registration Statements on page 927

Witness my hand this 7 day of May, 1958

Lewis A. Stanley  
(State Engineer)

By \_\_\_\_\_ (Deputy)