


Township 28 S. Range 6 W., W.M.

North

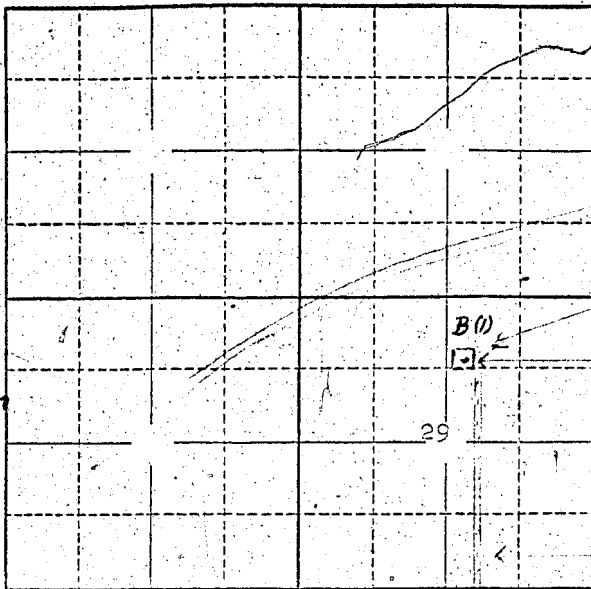

S. Umpqua River

72 A. irrigated

well

Locate well and acreage of irrigated land on plat.

Scale: 2" = 1 Mile

STATE OF OREGON

County of Douglas } ss.

I, Lawrence A. Hercher, being first duly sworn, do hereby certify that I have read the foregoing Registration Statement and that all of the items therein contained are true to the best of my knowledge and belief.

Lawrence A. Hercher
(Signature of Registrant)

Subscribed and sworn to before me this 31st day of January, 1958

My commission expires Aug 21 1960

[Signature of Notary Public]

(Notary Public)

(SEAL)

CERTIFICATE OF REGISTRATION

STATE OF OREGON

County of Marion } ss.

This is to certify that the foregoing Registration Statement was received in the office of the State Engineer on the 30th day of February, 1958, at _____ o'clock _____ M. and has been duly recorded in said office in Book No. 5 of Registration Statements on page 928.

Witness my hand this 7th day of May, 1958

[Signature of Lewis A. Stanley]

(State Engineer)

By _____ (Deputy)