


Township 6 S Range 2 W W.M.

North

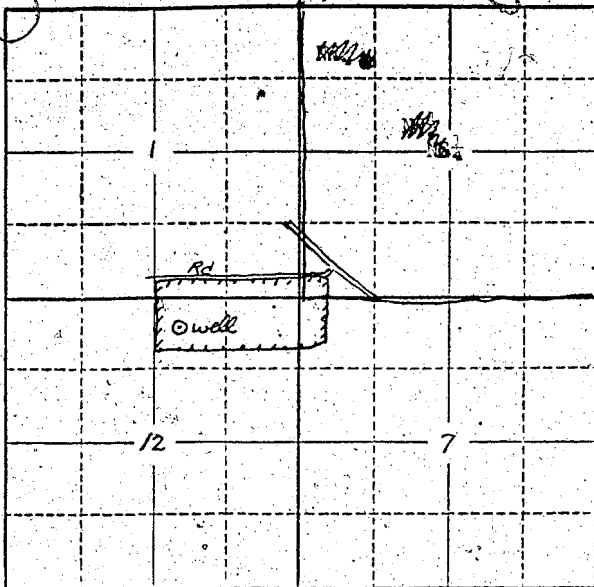

Locate well and acreage of irrigated land on plat.

Scale: 2" = 1 Mile

STATE OF OREGON

County of Marion } ss.

I, HENRY G. STOCKHOFF, being first duly sworn, do hereby certify that I have read the foregoing Registration Statement and that all of the items therein contained are true to the best of my knowledge and belief.

*Henry G. Stockhoff*  
(Signature of Registrant)

Subscribed and sworn to before me this 5 day of February, 1958.

My commission expires December 9, 1961

*Thomas H. [unclear]*  
(Notary Public)  
NOTARY PUBLIC FOR OREGON  
MY COMMISSION EXPIRES DEC. 9, 1961.

(SEAL)

CERTIFICATE OF REGISTRATION

STATE OF OREGON } ss.  
County of Marion

This is to certify that the foregoing Registration Statement was received in the office of the State Engineer on the 5 day of February, 1958, at 4:00 o'clock P.M. and has been duly recorded in said office in Book No. 5 of Registration Statements on page 934.

Witness my hand this 7 day of May, 1958.

*Lewis J. [unclear]*  
(State Engineer)

By \_\_\_\_\_ (Deputy)