


North

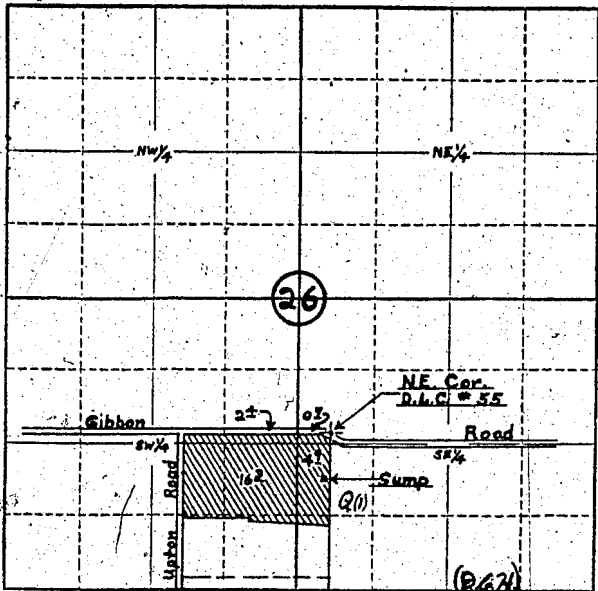

Locate well and acreage of irrigated land on plat.

Scale: 4" = 1 Mile

STATE OF OREGON

County of Jackson } ss.

I, Dan Mac Scott, being first duly sworn, do hereby certify that I have read the foregoing Registration Statement and that all of the items therein contained are true to the best of my knowledge and belief.

Signature of Registrant: Dan John Scott

Subscribed and sworn to before me this 7th day of Feb, 1958

My commission expires Nov 27 1962 (Notary Public)

(SEAL)

CERTIFICATE OF REGISTRATION

STATE OF OREGON } ss. County of Marion

This is to certify that the foregoing Registration Statement was received in the office of the State Engineer on the 10th day of February, 1958, at 2:00 o'clock P.M. and has been duly recorded in said office in Book No. 5 of Registration Statements on page 955.

Witness my hand this 28 day of May, 1958

Signature of State Engineer: Lewis A. Stanley

By (Deputy)