


North

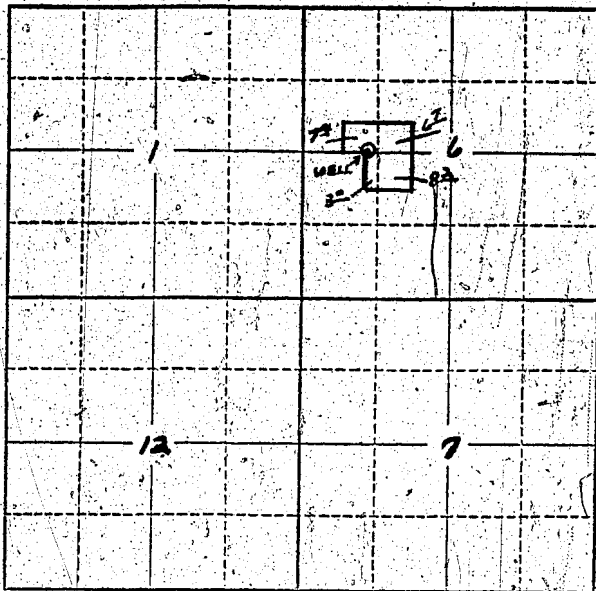

Locate well and acreage of irrigated land on plat.  
Scale: 2" = 1 Mile

STATE OF OREGON

County of Lin } ss.

I, Herman and Lena Krusi, being first duly sworn, do hereby certify that I have read the foregoing Registration Statement and that all of the items therein contained are true to the best of my knowledge and belief.

Herman Krusi

Lena Krusi  
(Signature of Registrant)

Subscribed and sworn to before me this 31st day of January, 1956

My commission expires Aug 4, 1957

Satanalee Strait  
(Notary Public)

(SEAL)

**CERTIFICATE OF REGISTRATION**

STATE OF OREGON } ss.  
County of Marion

This is to certify that the foregoing Registration Statement was received in the office of the State Engineer on the 2nd day of February, 1956, at 8 o'clock AM and has been duly recorded in said office in Book No. 1 of Registration Statements on page GR-130 C

Construction shall be completed by October 1956 and the water completely applied to beneficial use by October 1956

Witness my hand this 8th day of October, 1956

Lewis A. Stanley  
(State Engineer)

By \_\_\_\_\_  
(Deputy)