Township 5S Range 4W, W.M.

North

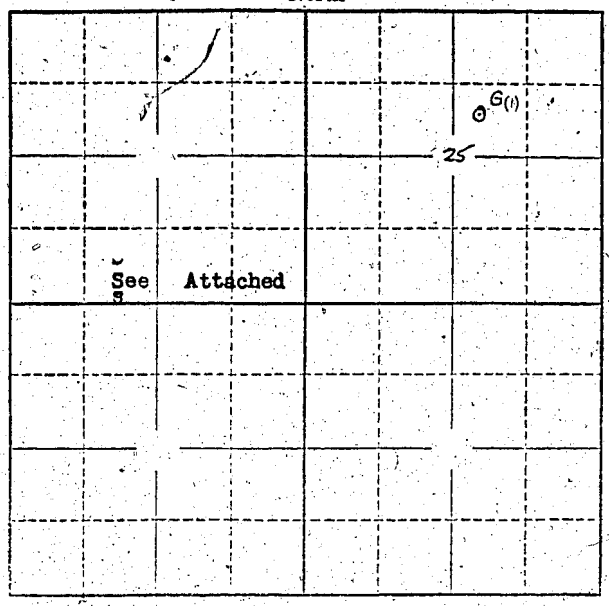

Locate well and acreage of irrigated land on plat.

Scale: 2" = 1 Mile

STATE OF OREGON
County of Yamhill } ss.

I, Peter Parvin, being first duly sworn, do hereby certify that I have read the foregoing Registration Statement and that all of the items therein contained are true to the best of my knowledge and belief.

Peter Parvin
(Signature of Registrant)

Subscribed and sworn to before me this 10th day of February, 1958

My commission expires MY COMMISSION [illegible]

(Notary Public)

(SEAL)

CERTIFICATE OF REGISTRATION

STATE OF OREGON
County of Marion } ss.

This is to certify that the foregoing Registration Statement was received in the office of the State Engineer on the 11 day of February, 1958, at 2:00 o'clock A M. and has been duly recorded in said office in Book No. 5 of Registration Statements on page 960.

~~Construction shall be completed by X-X-X-X-X-X-X-X-X-X-19-X-X, and the water completely applied to beneficial use by X-X-X-X-X-X-X-X-X-X-19-X-X~~

Witness my hand this 28 day of May, 1958

Laurence A. Stanley
(State Engineer)

By
(Deputy)

GR- 960 C