


T. 30S. R. 10&11 E. W. M.

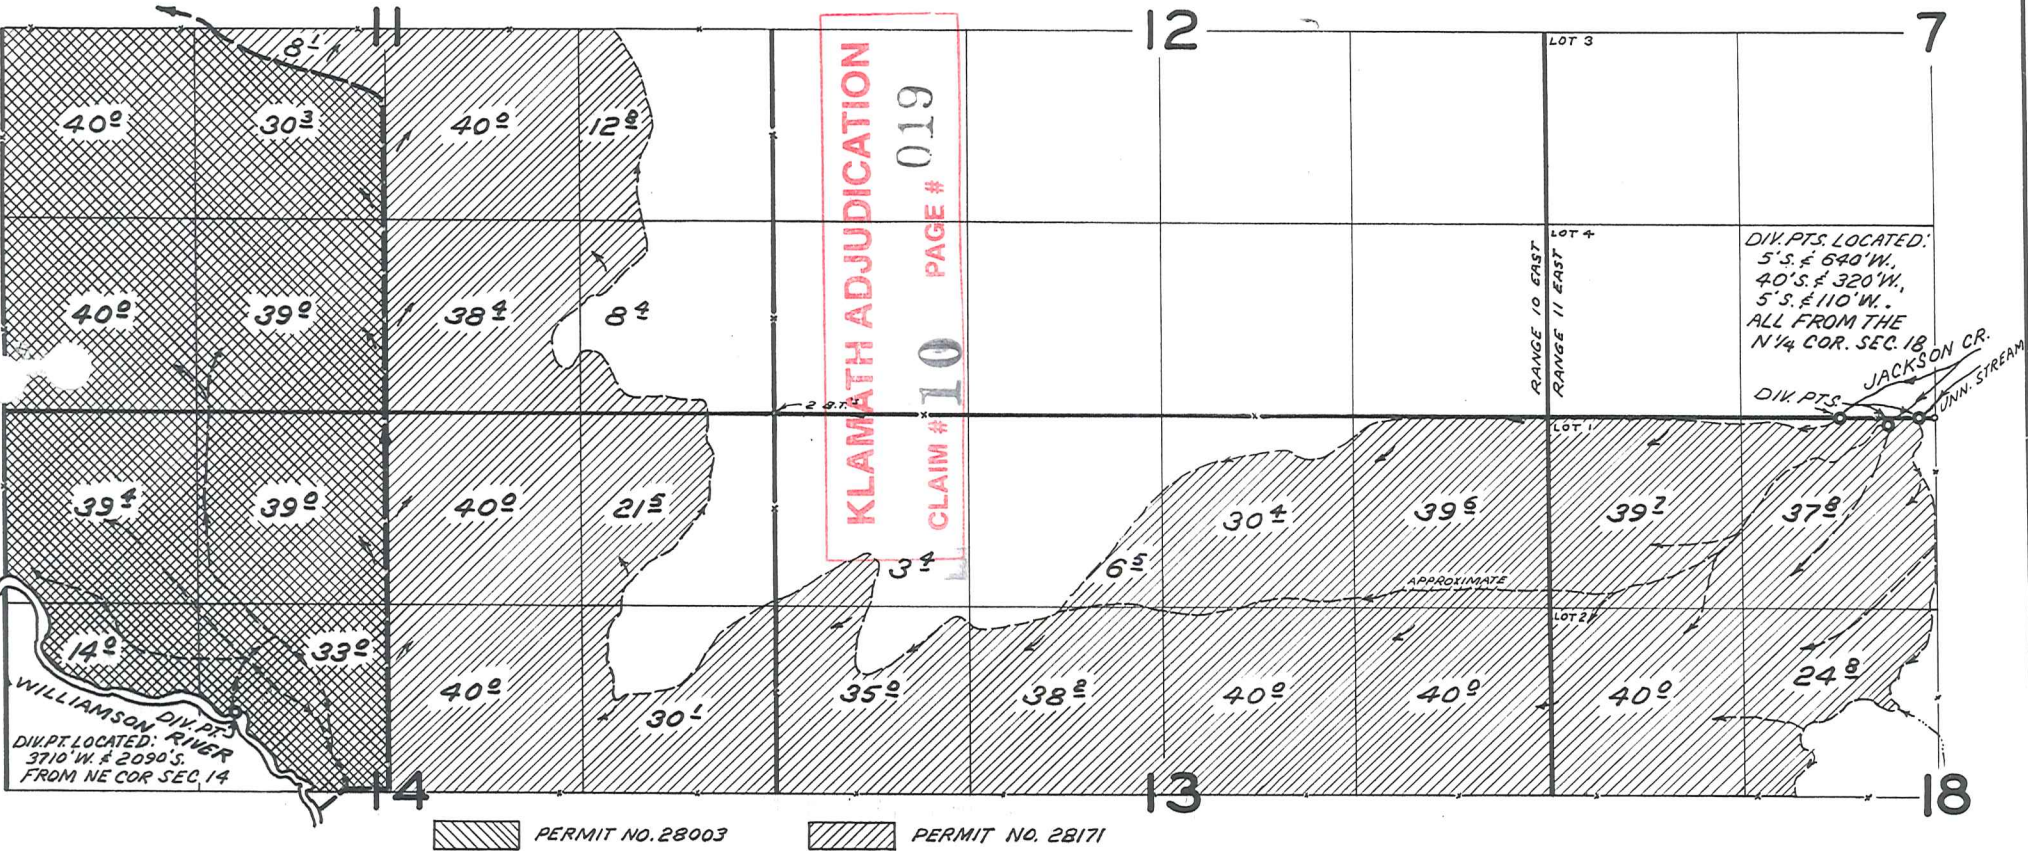

FINAL PROOF SURVEY

UNDER

APPLICATION NO. 37574, PERMIT NO. 28171
37587 28003

IN NAME OF

ESTATE OF MRS. ANNIE FRANCIS

SURVEYED JUN. 25, 1967, BY V. GARNER

*EXCEPTED AS DRAWEN
Kenneth I. Huffard*

RECEIVED

OCT 06 1998

WATER RESOURCES DEPT.
SALEM, OREGON