





EXISTING POINTS OF DIVERSION		
Point of Diversion	T35S R7E S3 SESE	125' East of the NW corner of the SESE of section 3

RELOCATED POINT OF DIVERSION		
Point of Diversion	T35S R7E S21 NENE	150' north and 180' east of the SW corner of the NENE of section 21, Lot 10

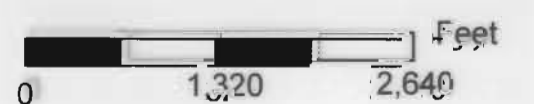

Disclaimer:
 This map was prepared for the purpose of identifying the location of a water right only, and is not intended to provide legal descriptions or locations of property ownership lines.

LEGEND	
	Existing Point of Diversion
	Relocated Point of Diversion
	Water Bodies
	Streams and Canals
	Roads
	Sections
	Quarter, Quarter Sections

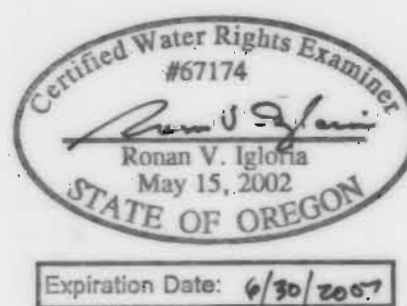

Expiration Date: 6/30/2007

Certified Water Rights Examiner

Ronan Igloria, PE CWRP
 1001 SW 5th Ave., Suite 1310
 Portland, Oregon 97204
 Oregon Certificate Number: 67174WRE

RECEIVED
 DEC 01 2006
 WATER RESOURCES DEPT
 SALEM OREGON

**Map for Alteration to Water Rights Claim #269
 Relocated Point of Diversion
 Klamath Basin Adjudication**

Township 35 South, Range 7 East, W1M,
 Klamath County, Oregon

Stephen and Beverly Larig
 2929 Oak Road
 Chiloquin, OR 97624

