


Certificates #: 85849, 85846, 85850, 85851, 85852, 85853

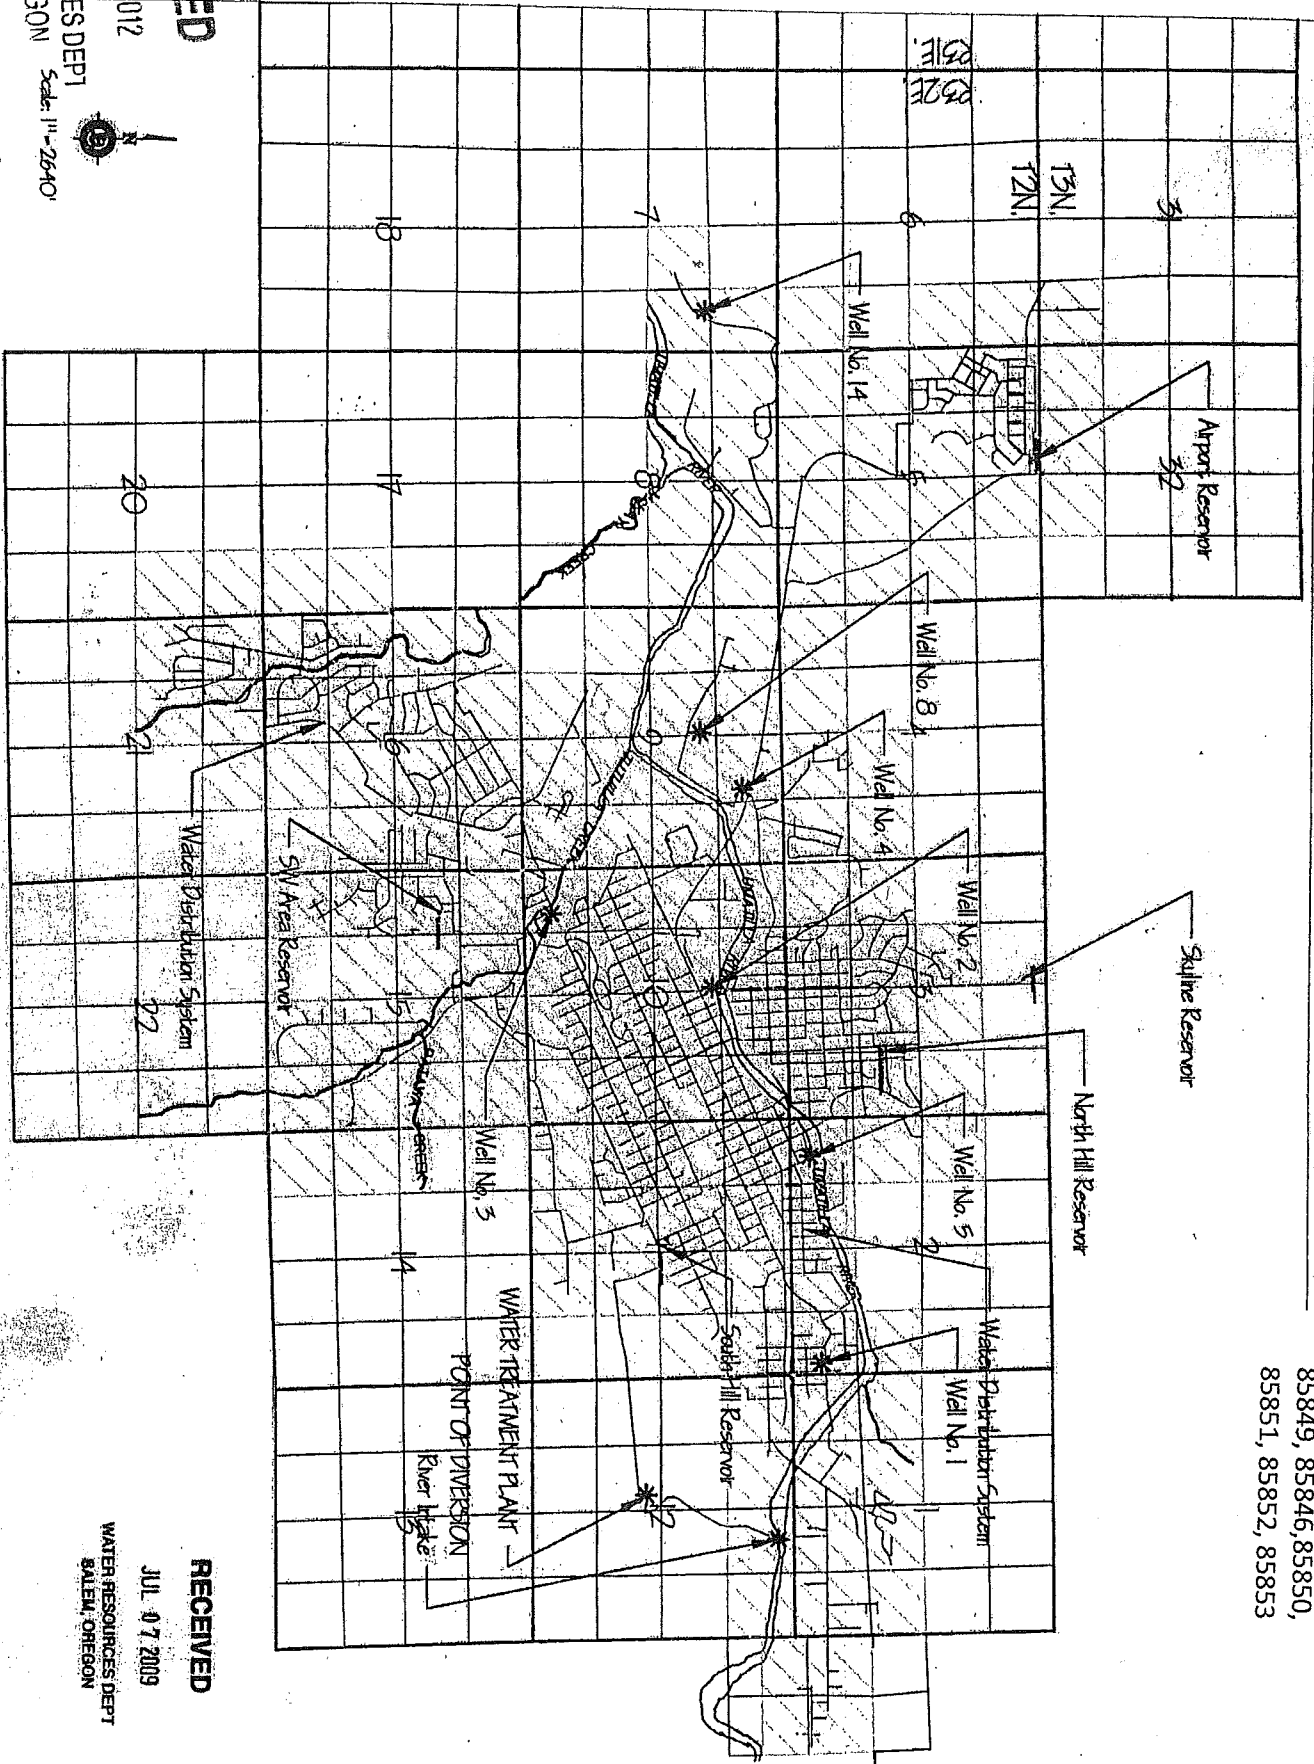

IVED
 4 2012
 WRCES DEPT
 OREGON
 Scale: 1" = 2640'

RECEIVED
 JUL. 07 2009
 WATER RESOURCES DEPT
 SALEM, OREGON

COBBLE MAP #0441 3044

City of Pendleton, Ore
 Water Distribution Sys
 Claim of Beneficial Use
 Township 2N, Range 32E, W4M

Transfer # T-8761
 Permit: S-472, S-1197, S-90
 S-9007

Transfer # T-8712
 Permit: Umatilla River Decree D

Transfer # T-8640
 Permit: Umatilla River Decree D

Legal Description
 Part of Division is 297' x 619' East of the N1/4
 corner of Section 12, Township
 Range 32E, W4M.

Notes:
 1. The required fish screen is part of the intake structure extending into the Umatilla River.
 2. The required flow meter is located at the inlet to the Water Treatment Plant.

- This map is not intended to provide legal dimensions or locations of property ownership lines.




Certificate No.
86028

RECEIVED

APR 04 2012

WATER RESOURCES DEPT
SALEM, OREGON

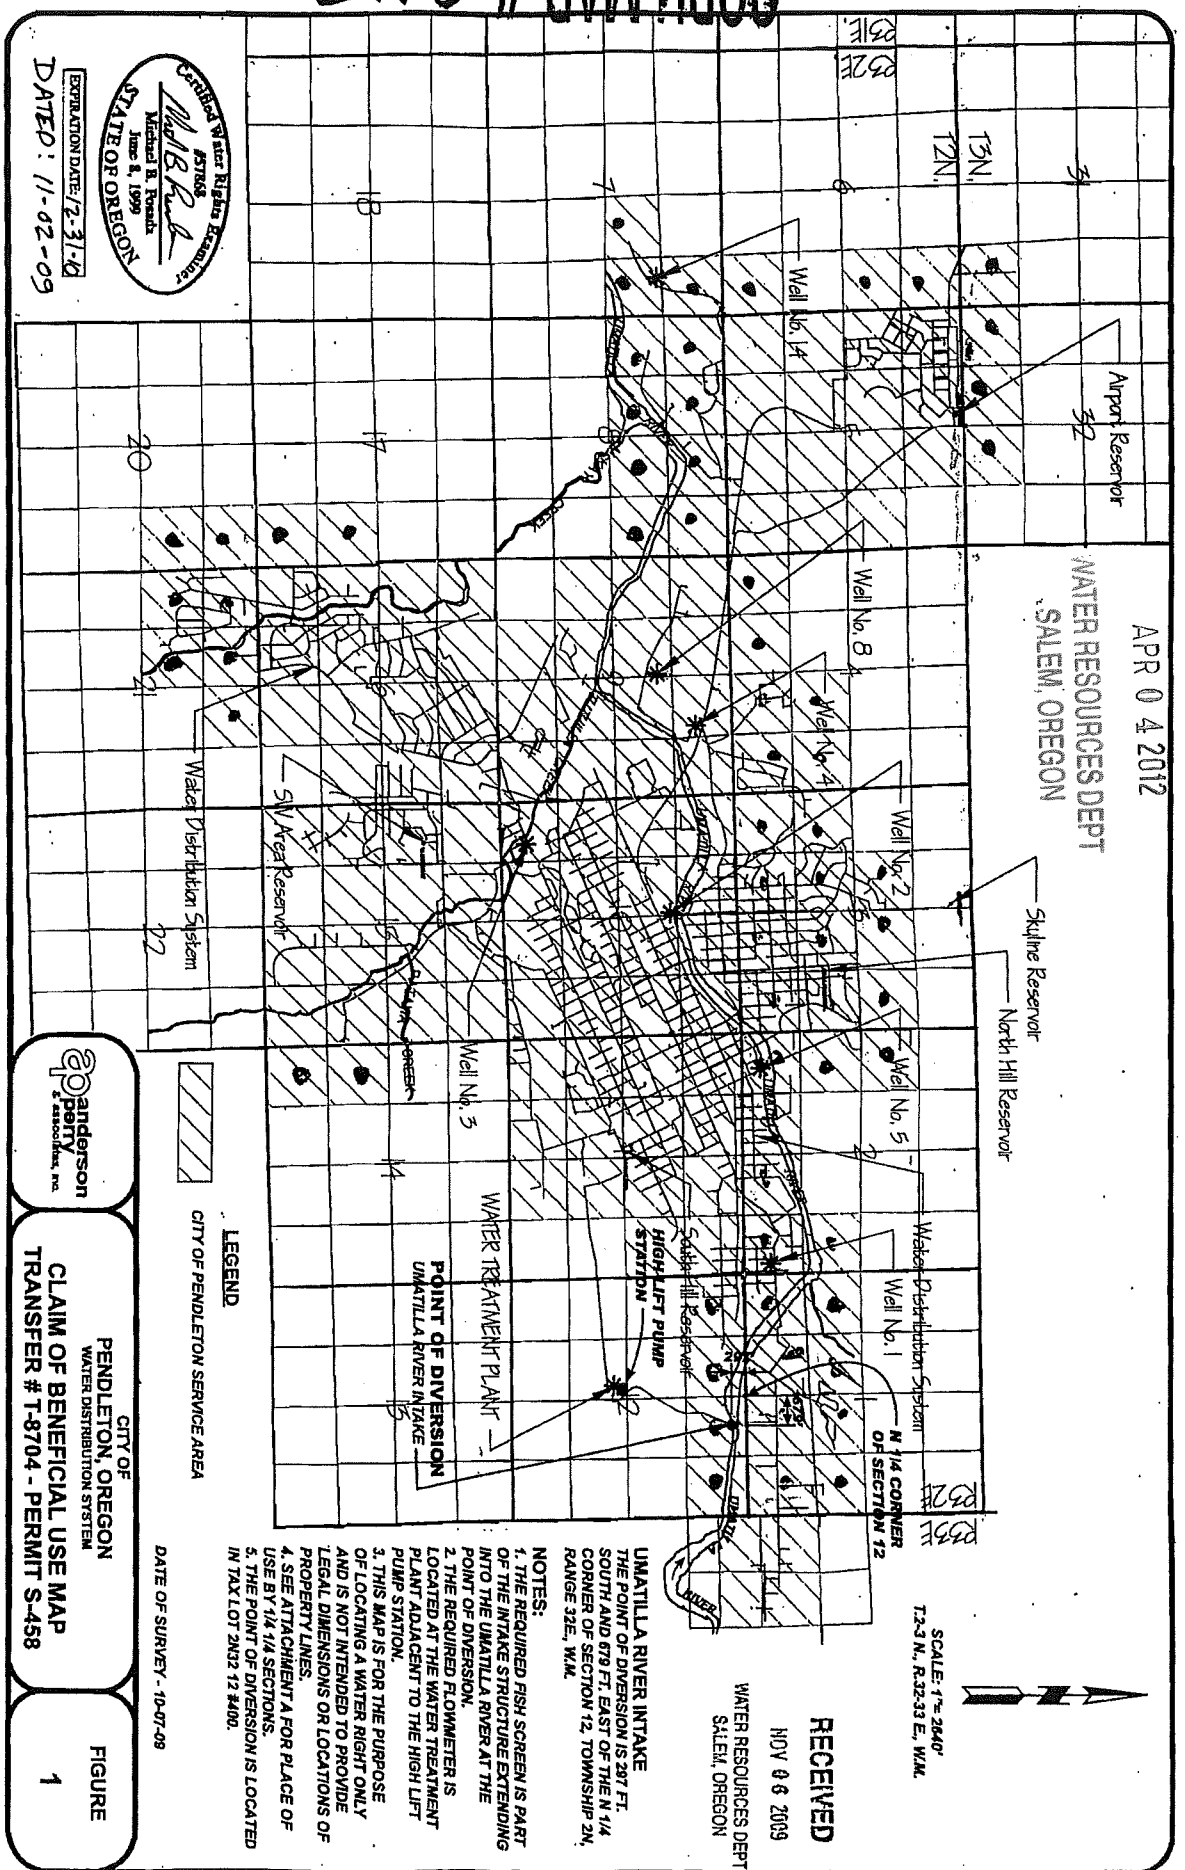

COBU MAP # 0475

Michael E. Poyak
June 8, 1999
STATE OF OREGON

EXPIRATION DATE: 2-3-10
DATED: 11-02-09

Anderson
& Associates, Inc.

CITY OF
PENDLETON, OREGON
WATER DISTRIBUTION SYSTEM
CLAIM OF BENEFICIAL USE MAP
TRANSFER # T-8704 - PERMIT S-458

FIGURE
1

NOTES:
1. THE REQUIRED FISH SCREEN IS PART OF THE INTAKE STRUCTURE EXTENDING INTO THE UMATILLA RIVER AT THE POINT OF DIVERSION.
2. THE REQUIRED FLOWMETER IS LOCATED AT THE WATER TREATMENT PLANT ADJACENT TO THE HIGH LIFT PUMP STATION.
3. THIS MAP IS FOR THE PURPOSE OF LOCATING A WATER RIGHT ONLY AND IS NOT INTENDED TO PROVIDE LEGAL DIMENSIONS OR LOCATIONS OF PROPERTY LINES.
4. SEE ATTACHMENT A FOR PLACE OF USE BY 1/4 SECTIONS.
5. THE POINT OF DIVERSION IS LOCATED IN TAX LOT 2N32 12 #400.


JB 77-13-217