


T.1S.,R.3W.,W.M. SECTION 8

POINT OF DIVERSION FOR PERMIT NO. 45455

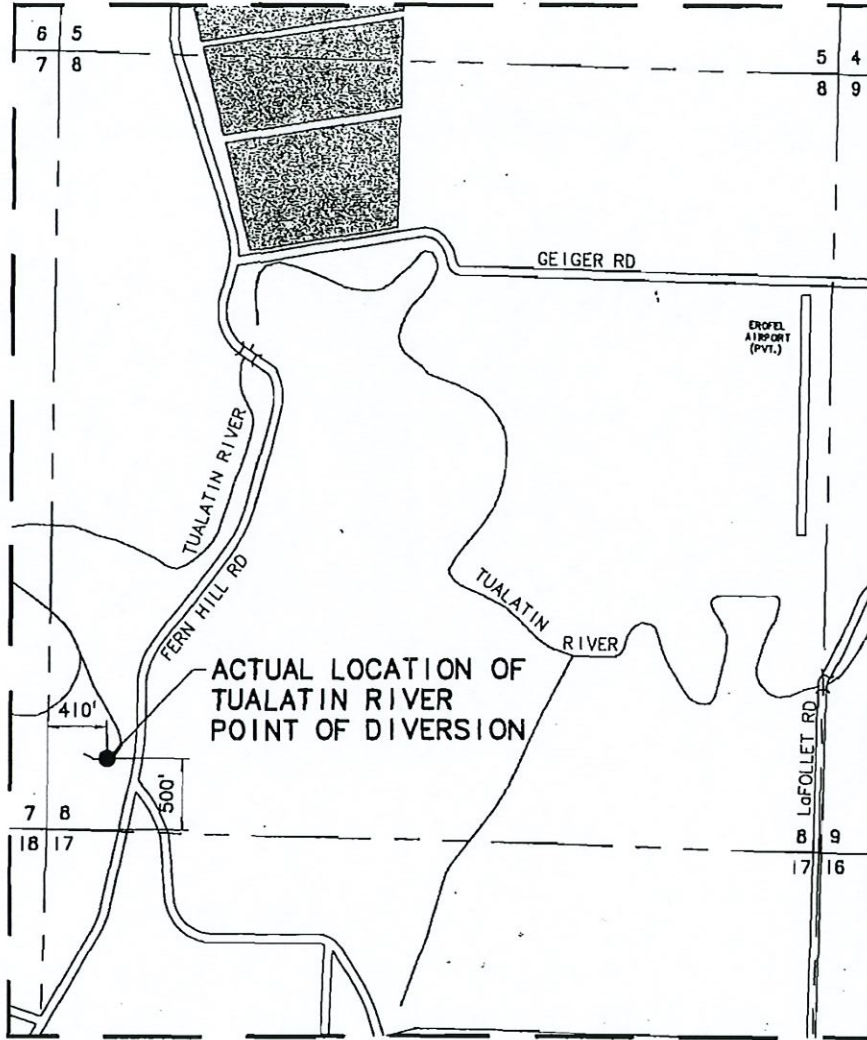

RECEIVED

DEC 10 2021

OWRD




SCALE:
1" = 1320'

FINAL PROOF SURVEY FOR PERFECTION OF
APPLICATION NO. 60357, PERMIT NO. 45455

IN THE NAME OF
THE CITY OF BEAVERTON
WASHINGTON COUNTY

MAY 2002

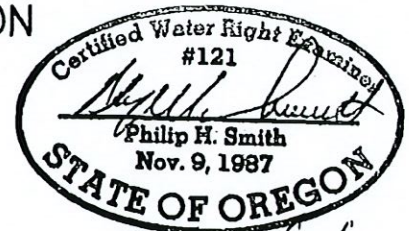

Expires 6/30/2002

NOTE: This map is for the purpose of identifying the location of the water right only and is not intended to provide legal dimensions or locations of property lines.