


RECEIVED

DEC 01 1992

WATER RESOURCES DEPT.
SALEM, OREGON

T.6S.R.4W.W.M.

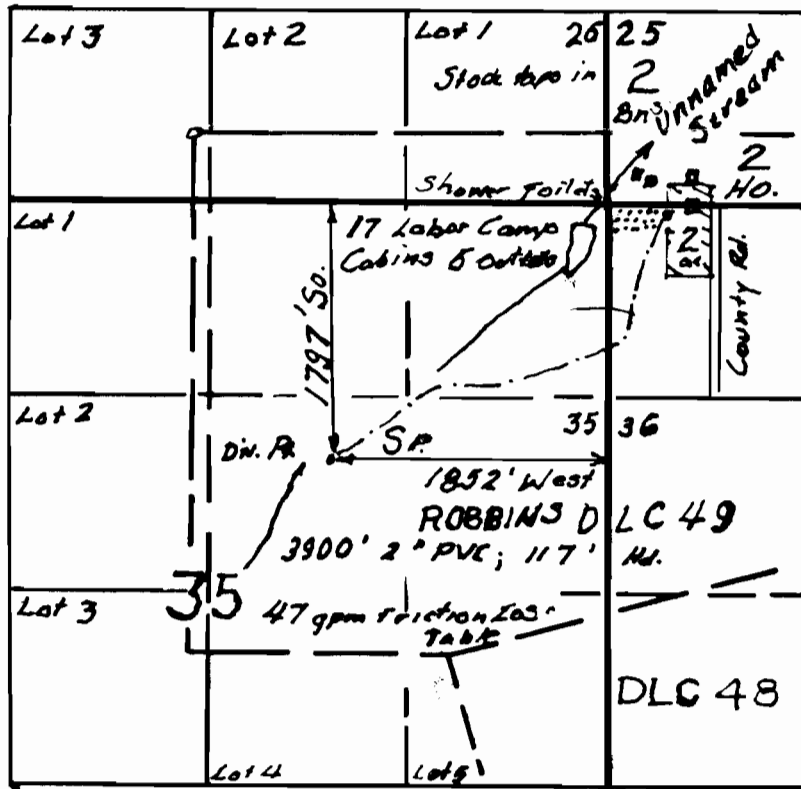

Scale: 1" = 1320

MAP FOR REGISTRATION STATEMENT
CLAIM OF RIGHT TO APPROPRIATE
SURFACE WATER OF

MARGARET H. SMART

11-3-90
11-12-92

