

RECEIVED

DEC - 1992

STATE OF OREGON  
DEPARTMENT OF AGRICULTURE


T.23S., R.7 W., W.M.

SCALE: 1" = 400'

REGISTRATION STATEMENT MAP

RECEIVED

SECTION 20

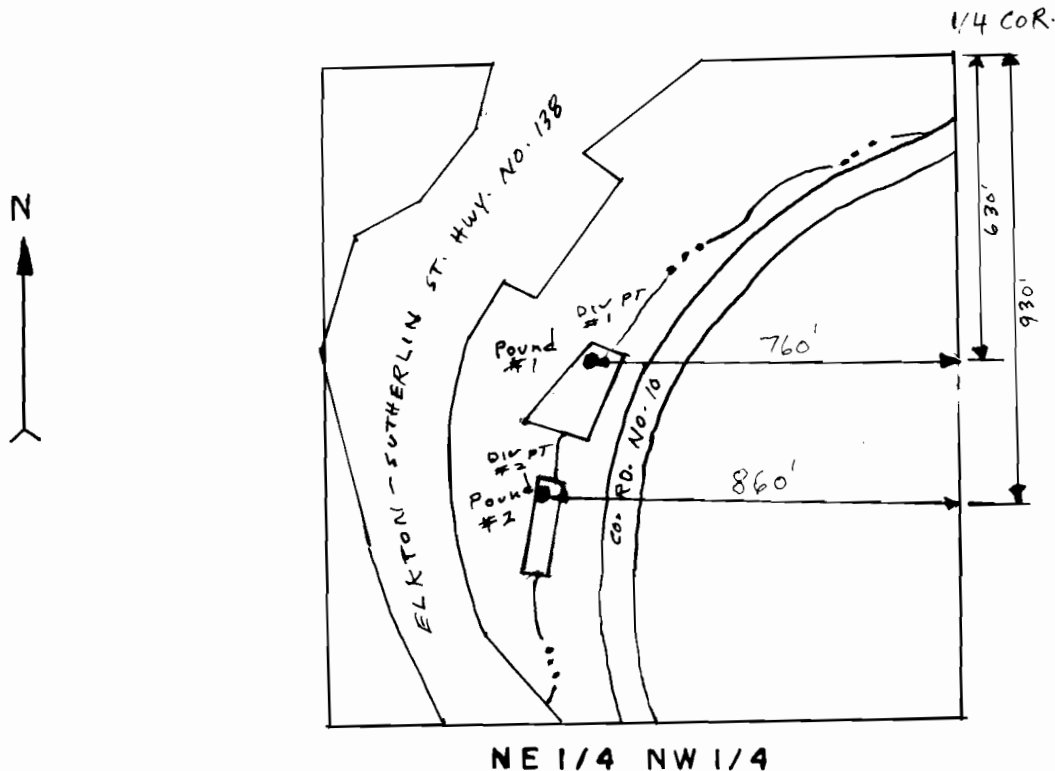

THE PURPOSE OF THIS MAP IS TO IDENTIFY THE LOCATION OF THE WATER RIGHT. IT IS NOT INTENDED TO PROVIDE INFORMATION RELATIVE TO THE LOCATION OF PROPERTY OWNERSHIP BOUNDARY LINES.

UNDER

IN NAME OF

TIM SHEPHERD

Surveyed AUG 30, 1992, by DUANE KIRBY

