


T. 10 S.R.9 W.W.M.
SECTION 1
LINCOLN COUNTY, OREGON

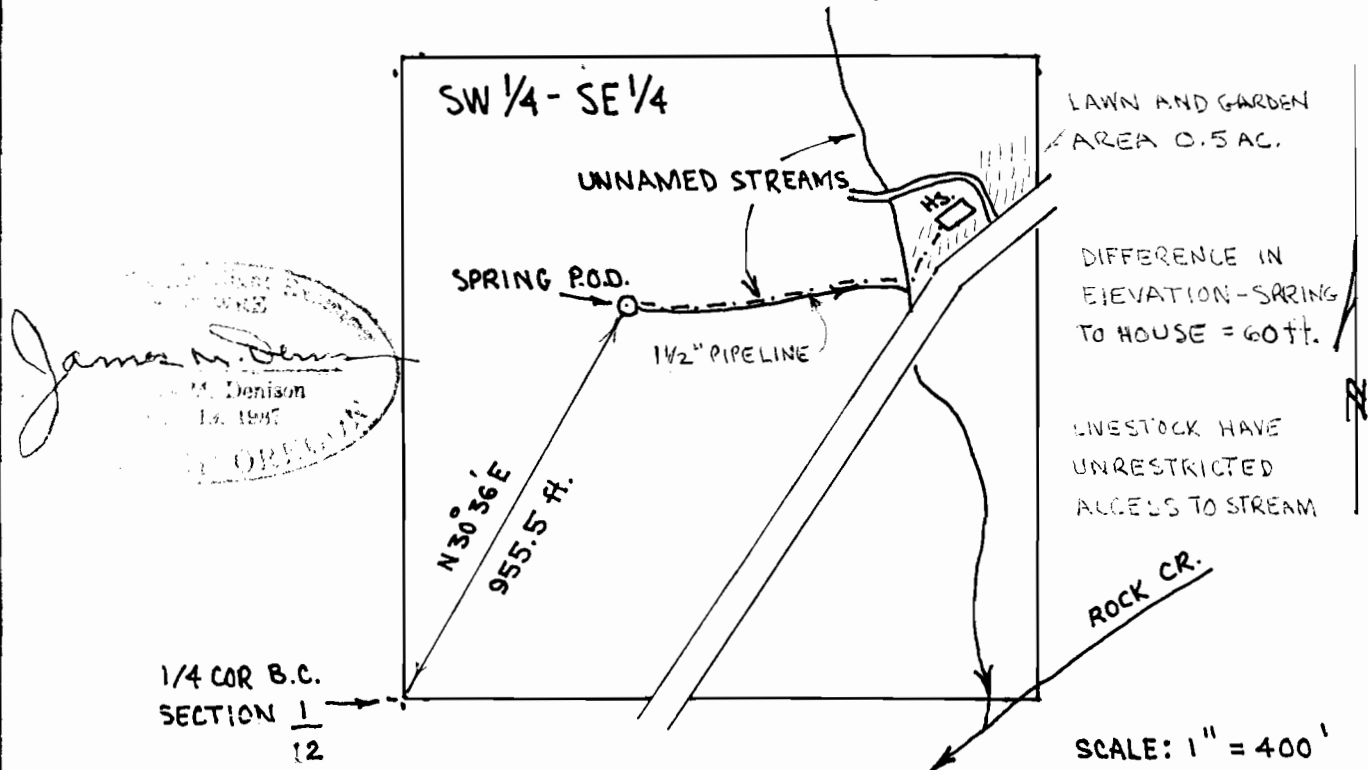

CLAIM OF BENEFICIAL USE MAP
FOR

SURFACE WATER REGISTRATION STATEMENT PRE-1909 VESTED WATER RIGHT CLAIM

APPLICATION # SWR-110 PERMIT #

IN THE NAME OF

HAROLD D. AND JOAN E. LOFTON

SURVEYED February 22, 1993

BY J. M. DENISON

This map prepared solely for the purpose of showing location of a water right, and is not intended for use to provide dimensions or location of property ownership lines.