


T28S.. R14W.. W1M.
COOS COUNTY OREGON

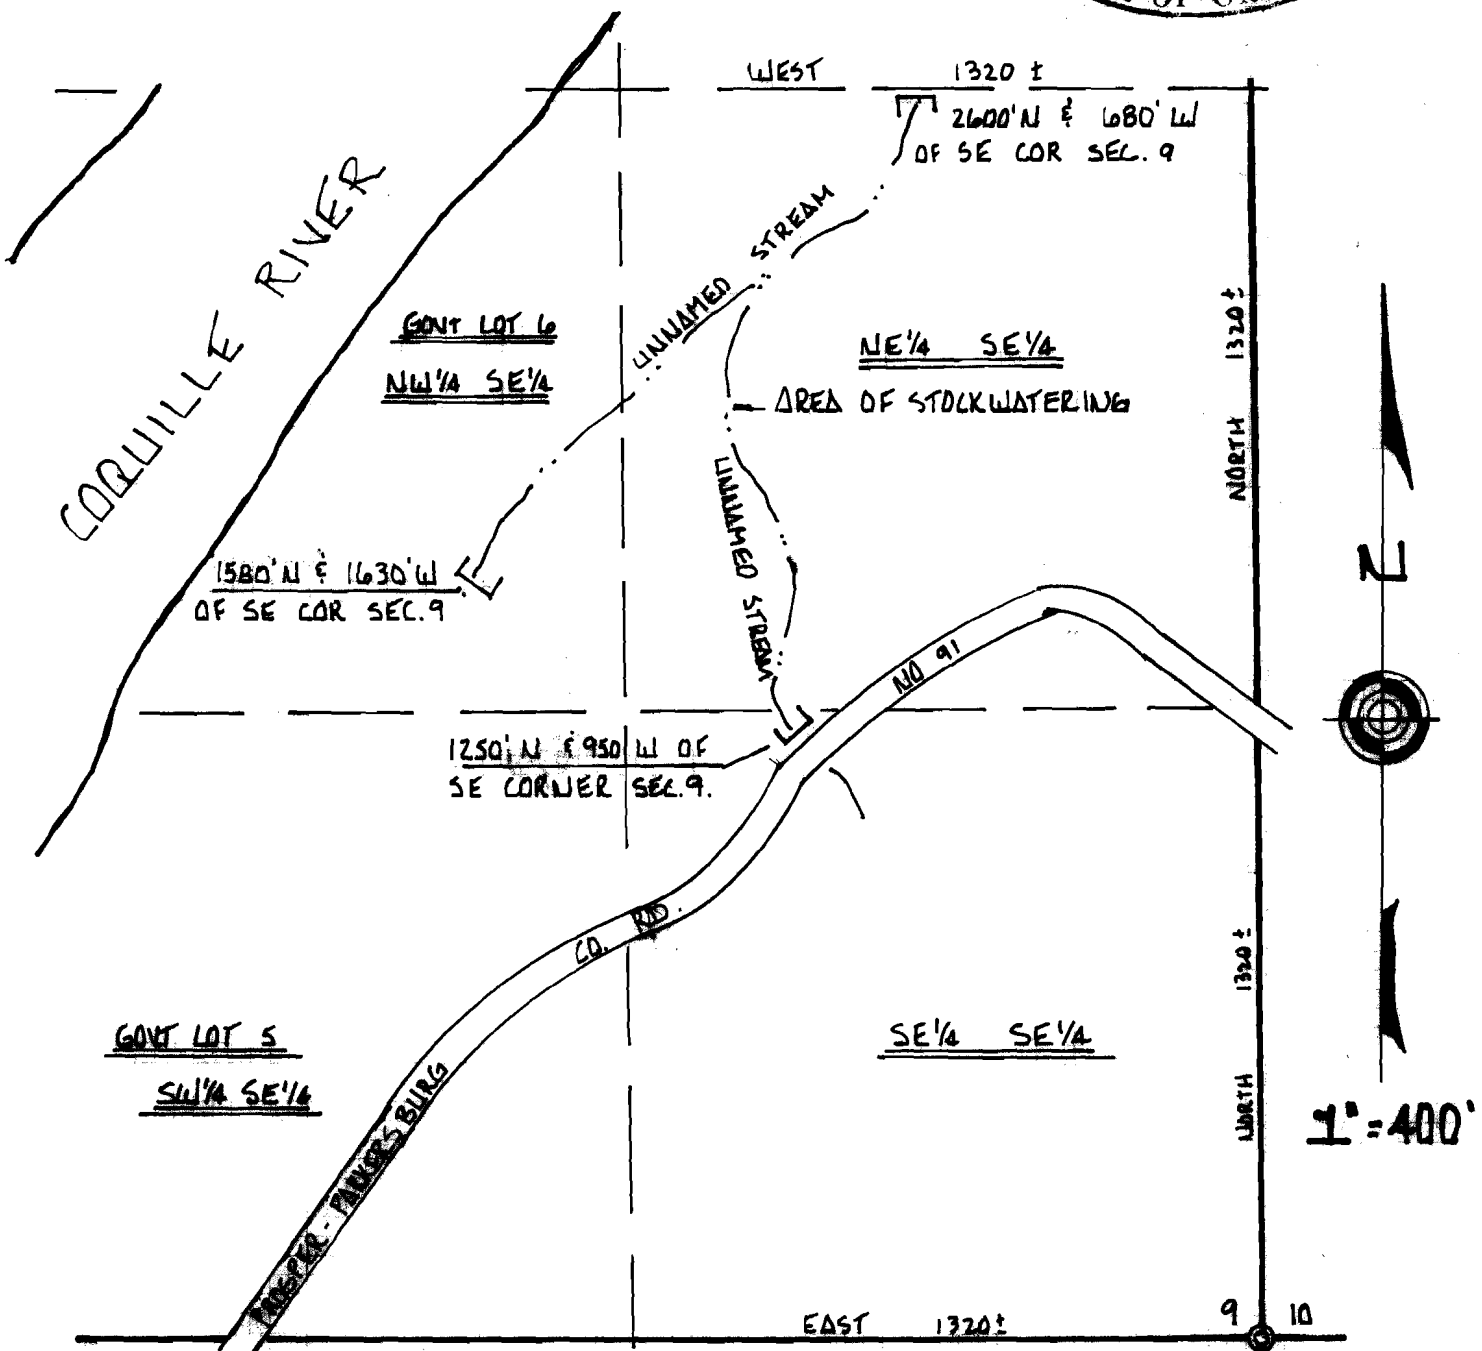

MAP TO ACCOMPANY A SURFACE WATER REGISTRATION STATEMENT
 PREPARED FOR: DOROTHY HERMAN
 Rt. 2 BOX 1055
 BANDON, OR 97411
 (503) 347-2751

PREPARED BY: PRAHAR SURVEYING
 1045 BALTIMORE #1
 BANDON, OR 97411
 (503) 347-9517

DATE: Dec. 9, 1992

DISCLAIMER: This map was prepared for the sole purpose of locating a water right and is not intended to show property lines or ownership lines.

- LEGEND: Ⓞ BRASS CAP IRON PIPE
 ⌊ LIMITS OF STOCKWATERING
 - - - - UNNAMED STREAMS