


T.6S., R.10 & 11W., W.M.

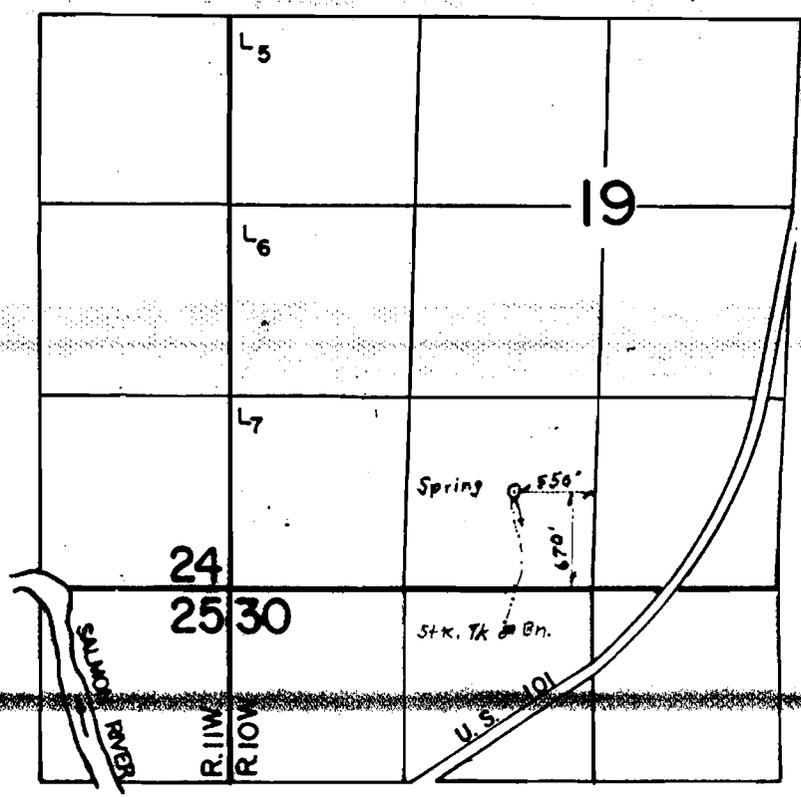

Scale: 1" = 1320'

MAP FOR
DON GNOS

Photo Survey on Nov. 12, 1992 by

THIS MAP WAS PREPARED FOR THE PURPOSE OF IDENTIFYING THE LOCATION OF A WATER RIGHT ONLY AND IS NOT INTENDED TO PROVIDE LEGAL DIMENSIONS OR LOCATION OF PROPERTY OWNERSHIP LINES.

