


T28S, R5W, WM
SCALE 1" = 400'

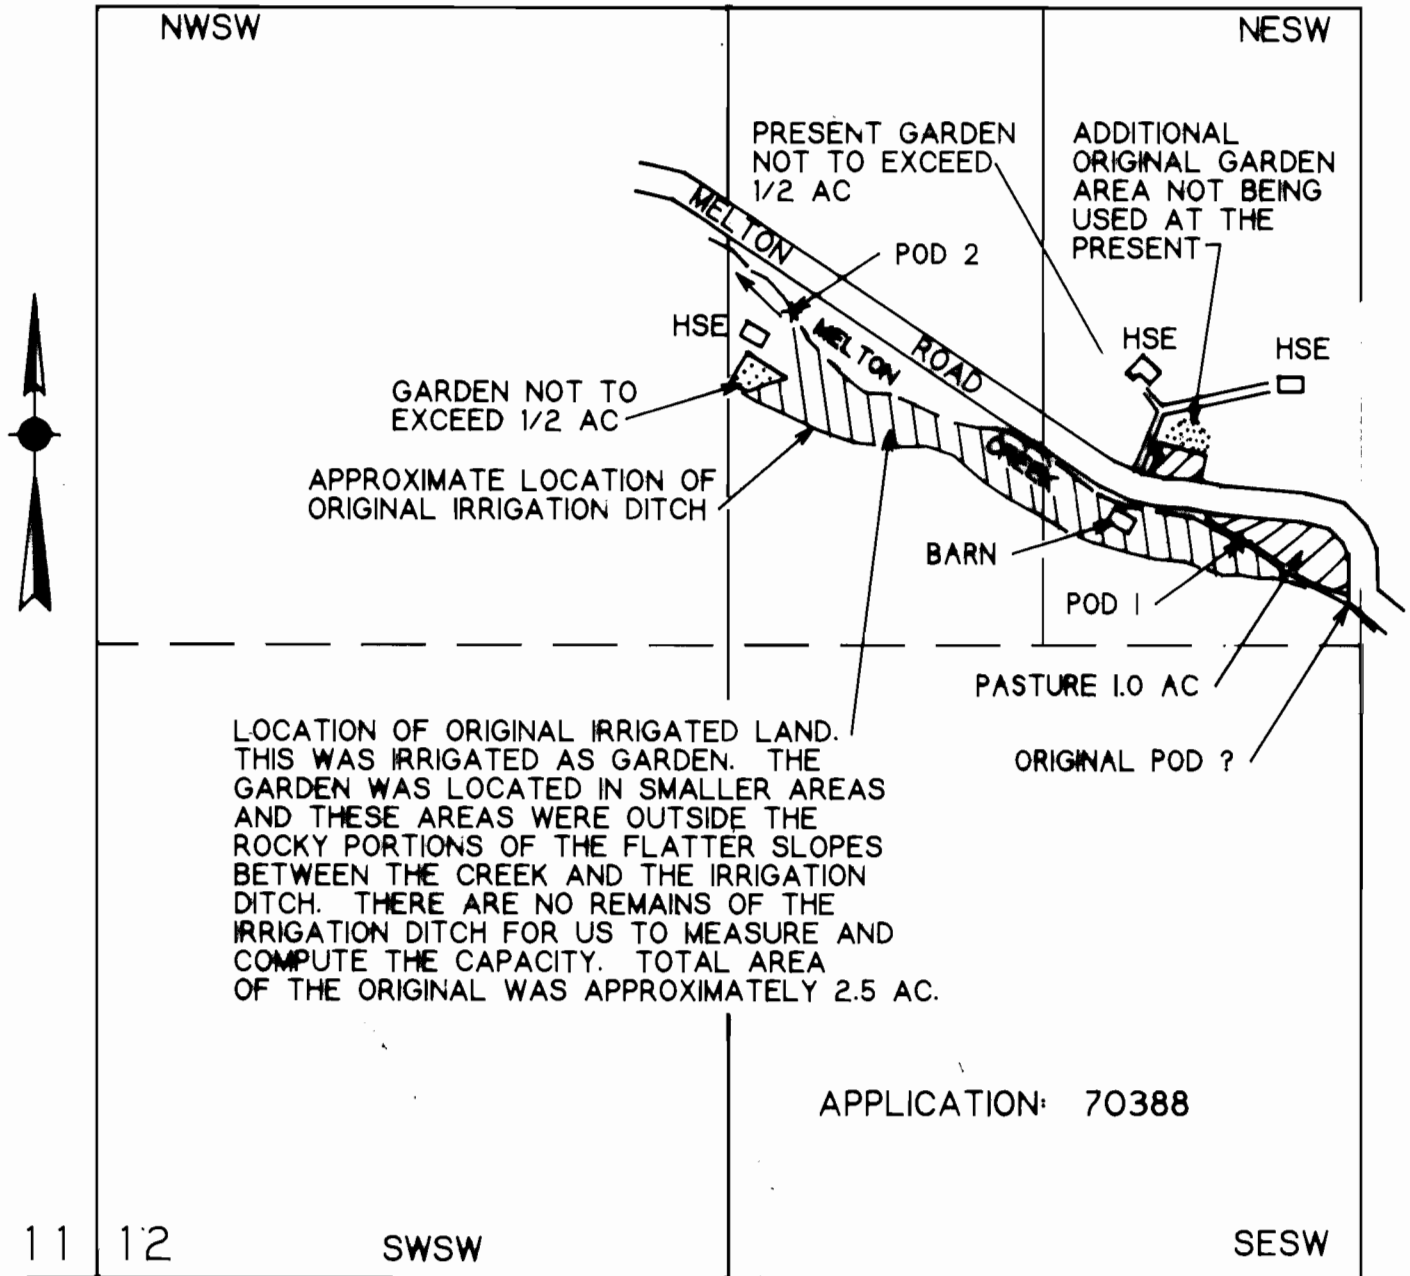

LOCATION OF ORIGINAL IRRIGATED LAND. THIS WAS IRRIGATED AS GARDEN. THE GARDEN WAS LOCATED IN SMALLER AREAS AND THESE AREAS WERE OUTSIDE THE ROCKY PORTIONS OF THE FLATTER SLOPES BETWEEN THE CREEK AND THE IRRIGATION DITCH. THERE ARE NO REMAINS OF THE IRRIGATION DITCH FOR US TO MEASURE AND COMPUTE THE CAPACITY. TOTAL AREA OF THE ORIGINAL WAS APPROXIMATELY 2.5 AC.

APPLICATION: 70388

11 12 SWSW SESW
14 13 ORIGINAL POD IS 1400 FT N AND 2620 FT E FROM SW COR SEC 12
POD 1 IS 1530 FT N AND 2390 FT E FROM SW COR SEC 12
POD 2 IS 2020 FT N AND 1450 FT E FROM SW COR SEC 12


VESTED WATER RIGHT MAP
PRE-1909 CLAIM OF BENEFICIAL USE

THIS IS A LOCATION MAP FOR A VESTED WATER RIGHT BY WILLIAM L OR CORA L FUMMERTON. THIS MAP IS FOR THE PURPOSE OF IDENTIFYING THE LOCATION OF THE VESTED WATER RIGHT ONLY AND IS NOT INTENDED TO PROVIDE LEGAL DIMENSIONS OR LOCATIONS OF PROPERTY OWNERSHIP LINES.



T28S, R5W, W1

SCALE 1" = 400'

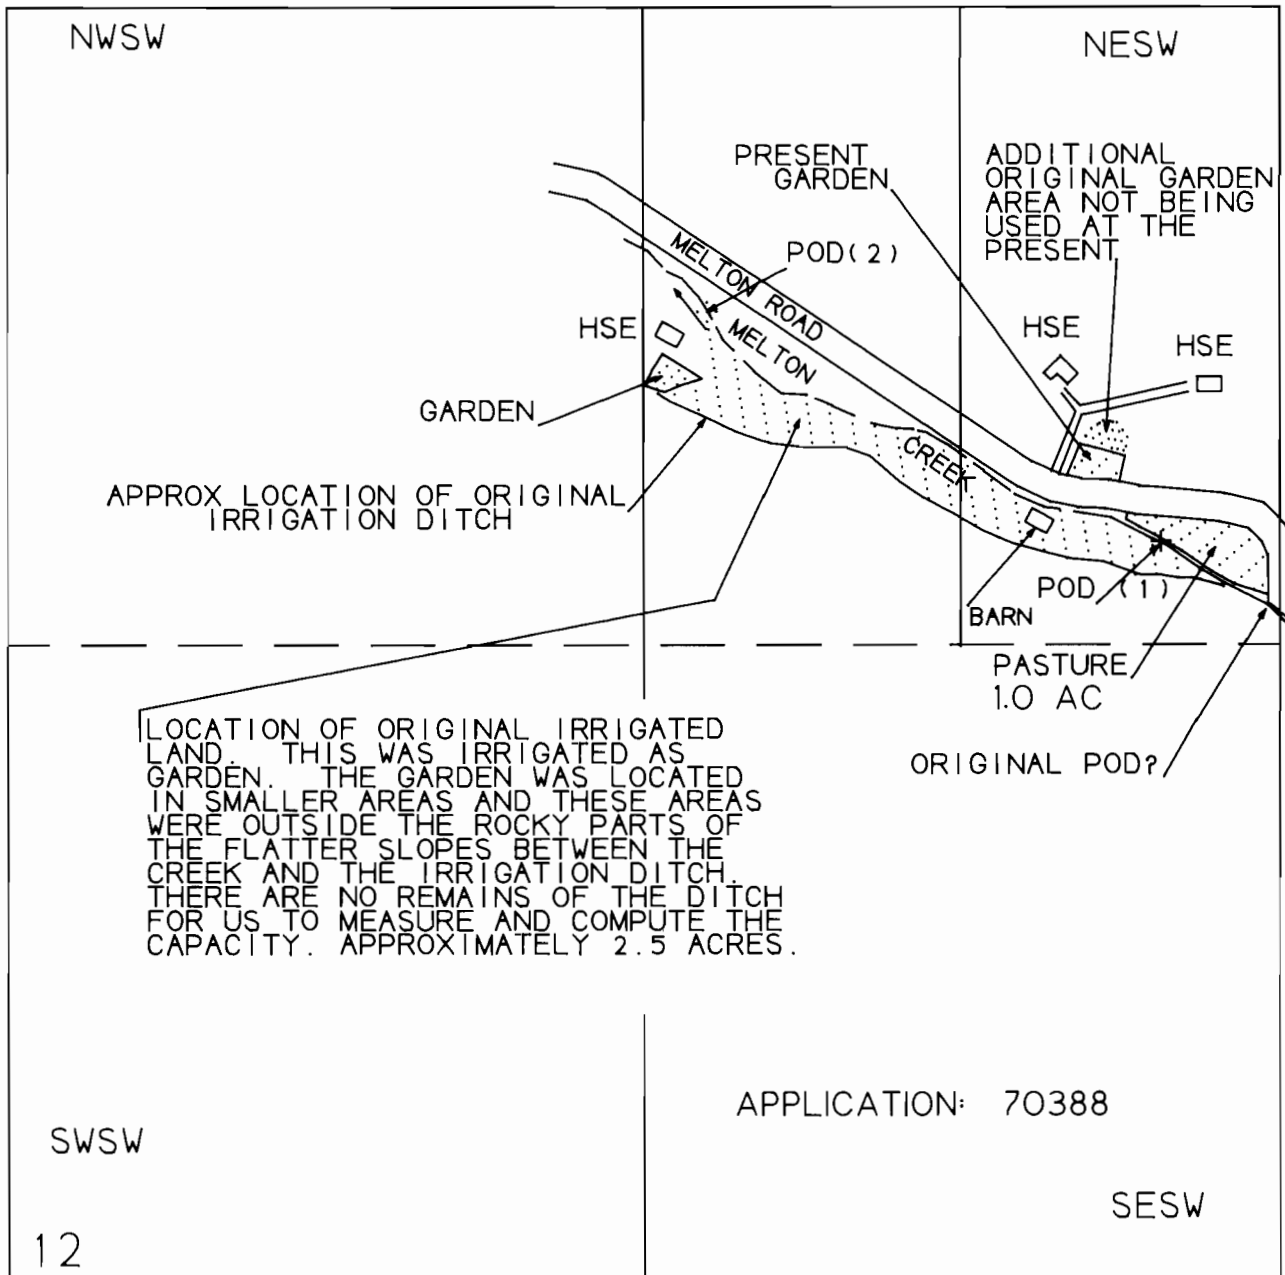

LOCATION OF ORIGINAL IRRIGATED LAND. THIS WAS IRRIGATED AS GARDEN. THE GARDEN WAS LOCATED IN SMALLER AREAS AND THESE AREAS WERE OUTSIDE THE ROCKY PARTS OF THE FLATTER SLOPES BETWEEN THE CREEK AND THE IRRIGATION DITCH. THERE ARE NO REMAINS OF THE DITCH FOR US TO MEASURE AND COMPUTE THE CAPACITY. APPROXIMATELY 2.5 ACRES.

APPLICATION: 70388

1 1 12
 1 4 1 3 ORIGINAL POD IS 1400 FT N AND 2620 FT E FROM SW COR SEC 12
 POD 1 IS 1530 FT N AND 2390 FT E FROM SW COR SEC 12
 POD 2 IS 2020 FT N AND 1450 E FROM SW COR SEC 12

VESTED WATER RIGHT MAP PRE-1909 CLAIM OF BENEFICIAL USE

THIS IS A LOCATION MAP FOR A VESTED WATER RIGHT BY WILLIAM L OR CORA L FUMMERTON. THIS MAP IS FOR THE PURPOSE OF IDENTIFYING THE LOCATION OF THE VESTED WATER RIGHT ONLY AND IS NOT INTENDED TO PROVIDE LEGAL DIMENSIONS OR LOCATIONS OF PROPERTY OWNERSHIP LINES.

