

SWR-135

RECEIVED

DEC 10 1992

WATER RESOURCES DEPT
SALEM, OREGON


T27S, R29E, WM

NOTES

1. THIS MAP WAS DRAWN FROM FIELD NOTES TAKEN ON FEB. 4, 1992.
2. BEARINGS ARE BASED ON SOLAR OBSERVATIONS.
3. ALL DITCHES AND CREEKS ON IRRIGATED LANDS SERVE AS STOCK WATERING FACILITIES.

LEGEND


- DIVERSION POINTS
- DITCHES
- /// IRRIGATED LANDS - SOURCE IS HUGHET CREEK.
- ||||| EARTHEN LEVEES

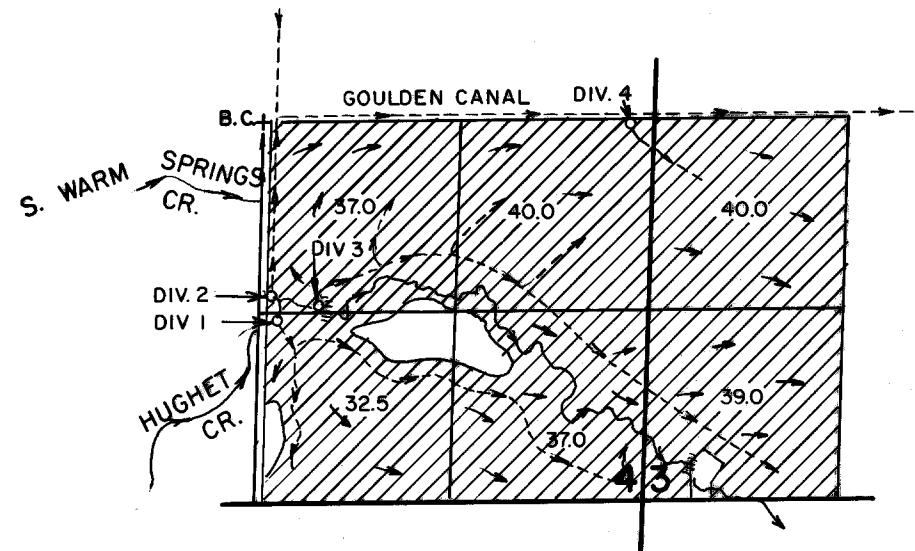

DIVERSION LOCATIONS

- DIV. 1, 1405' S, 110' E
 - DIV. 2, 1195' S, 40' E
 - DIV. 3, 1250' S, 340' E
 - DIV. 4, 10' S, 2520' E
- FROM C 1/4, SEC 4, T. 27 S., T. 29 S., W.M.

DITCH SECTIONS

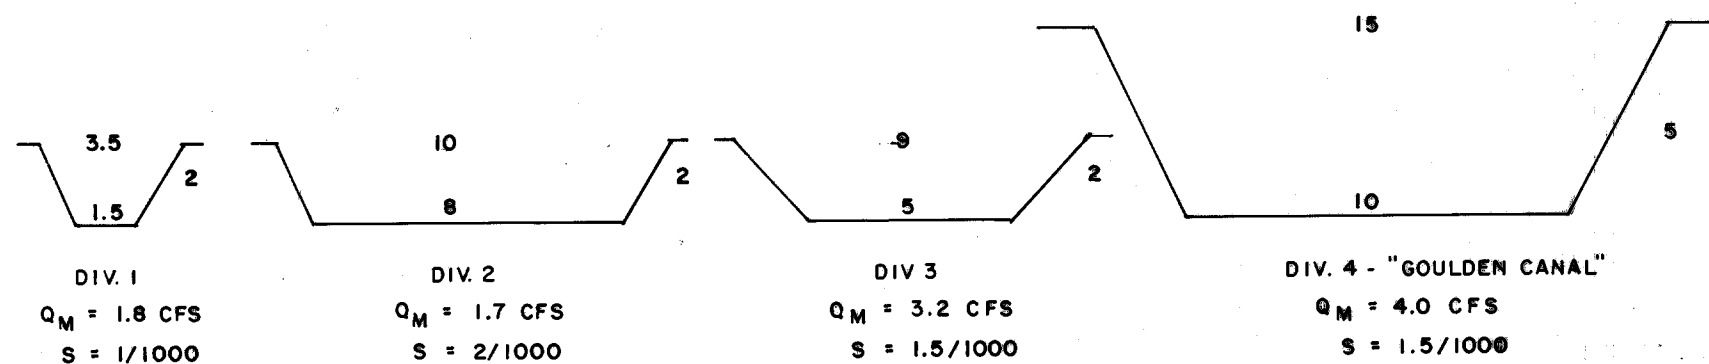

DIV. 1
Q_M = 1.8 CFS
S = 1/1000

DIV. 2
Q_M = 1.7 CFS
S = 2/1000

DIV. 3
Q_M = 3.2 CFS
S = 1.5/1000

DIV. 4 - "GOULDEN CANAL"
Q_M = 4.0 CFS
S = 1.5/1000

	HURLBURT RANCH INC		BURNS, OR
	VESTED WATER RIGHT APPLICATION MAP		
	Scale: 4" = 1 MILE	Date: FEB 1992	Job: 1370
	Dsn:		Sht. No.
Drn: CTP	of 1		
Ckd:	M. A. PALMER & SONS, INC. ENGINEERING & SURVEYING 254 N. Alder - Box 61 Burns, Oregon 97720		