


T.28.S. R.14W.W.M.

COUNTY OF COOS, OREGON

MAP TO ACCOMPANY THE APPLICATION FOR SURFACE WATER REGISTRATION STATEMENT
PRE-1909 VESTED WATER RIGHT CLAIM

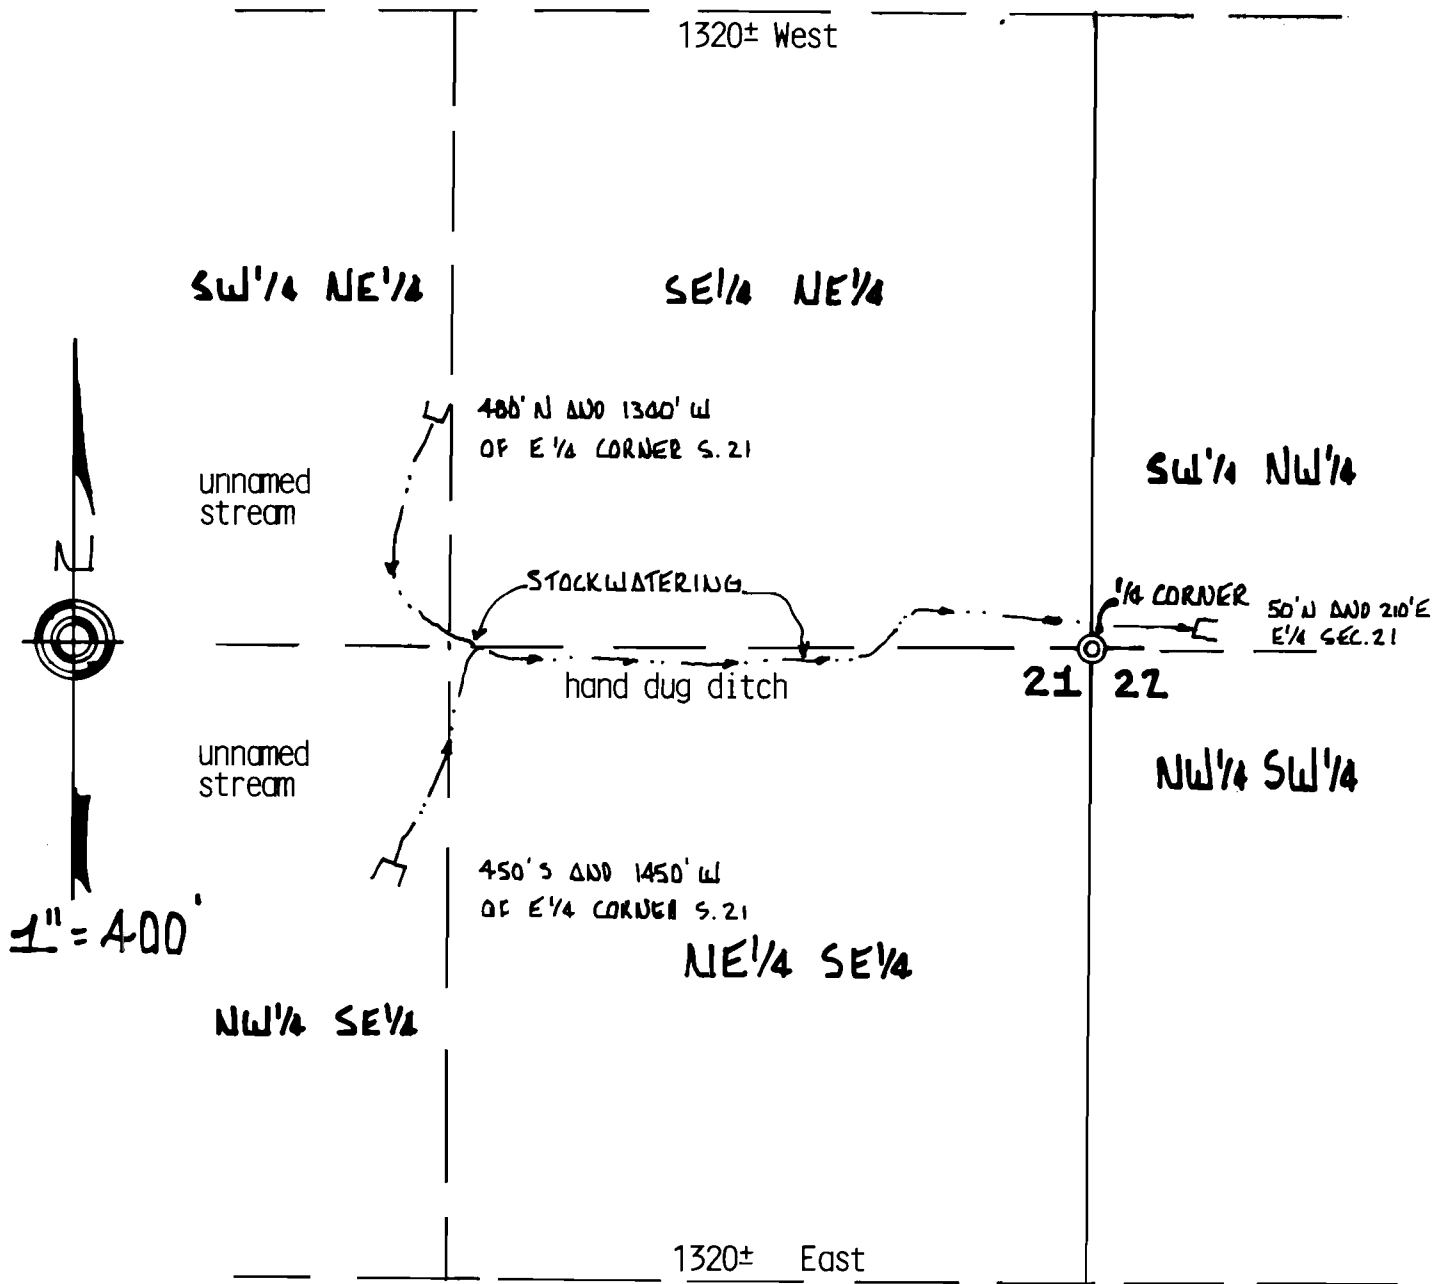

PREPARED FOR: ROSS D. AND PEARL N. JENKINS
Rt. 2 BOX 557
BANDON, OR 97411
(503)347-2385

PREPARED BY: PRAHAR SURVEYING
1045 BALTIMORE #1
BANDON, OR 97411
(503)347-9517

DATE: Dec. 7, 1992

LEGEND: BCIP
 unnamed streams and ditches
 limits of uses stockwatering

DISCLAIMER

This map was prepared for the sole purpose of locating a water right and is not intended to show property lines of ownership boundaries.

