


T. 7 S. R. 1 E. W.M.

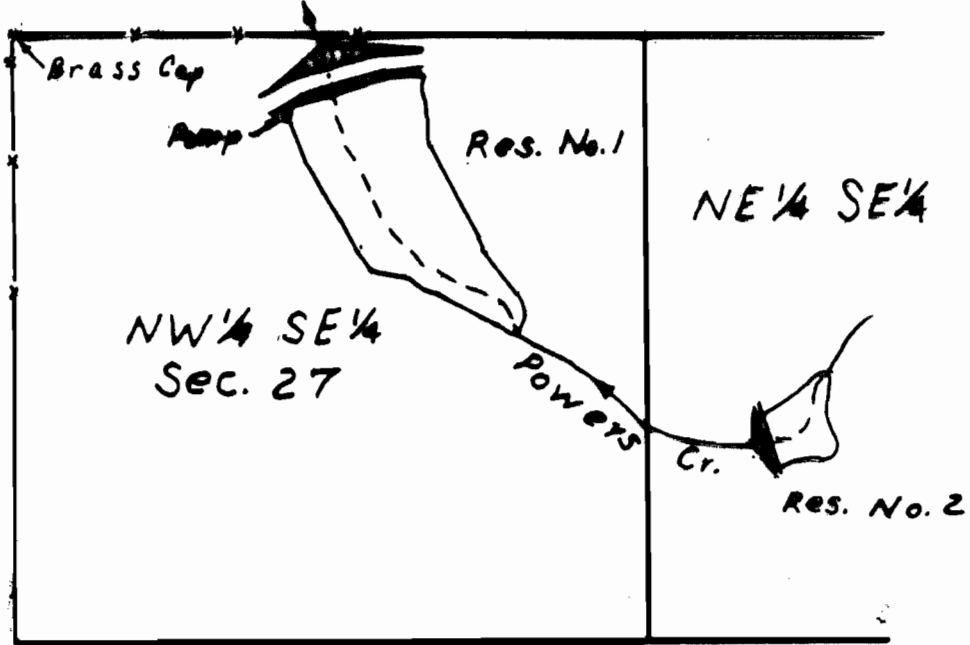

Div. Pt. No. 1: 90'S & 660'E.


Div. Pt. No. 2: 850'S & 1570'E.

both from Brass Cap Center Sec. 27

WATER RIGHT MAP FOR

Cascade West Trees, Inc.

THIS MAP WAS PREPARED FOR THE PURPOSE OF IDENTIFYING THE LOCATION OF A WATER RIGHT ONLY AND IS NOT INTENDED TO PROVIDE LEGAL DIMENSIONS OR LOCATION OF PROPERTY OWNERSHIP LINES.

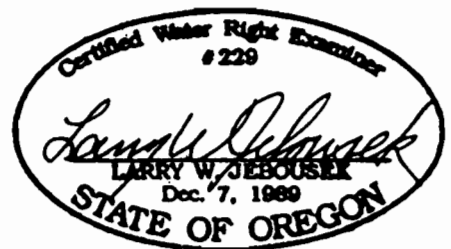

PTS July 26, 1993