


T. 12 S., R. 45 E., W.M.

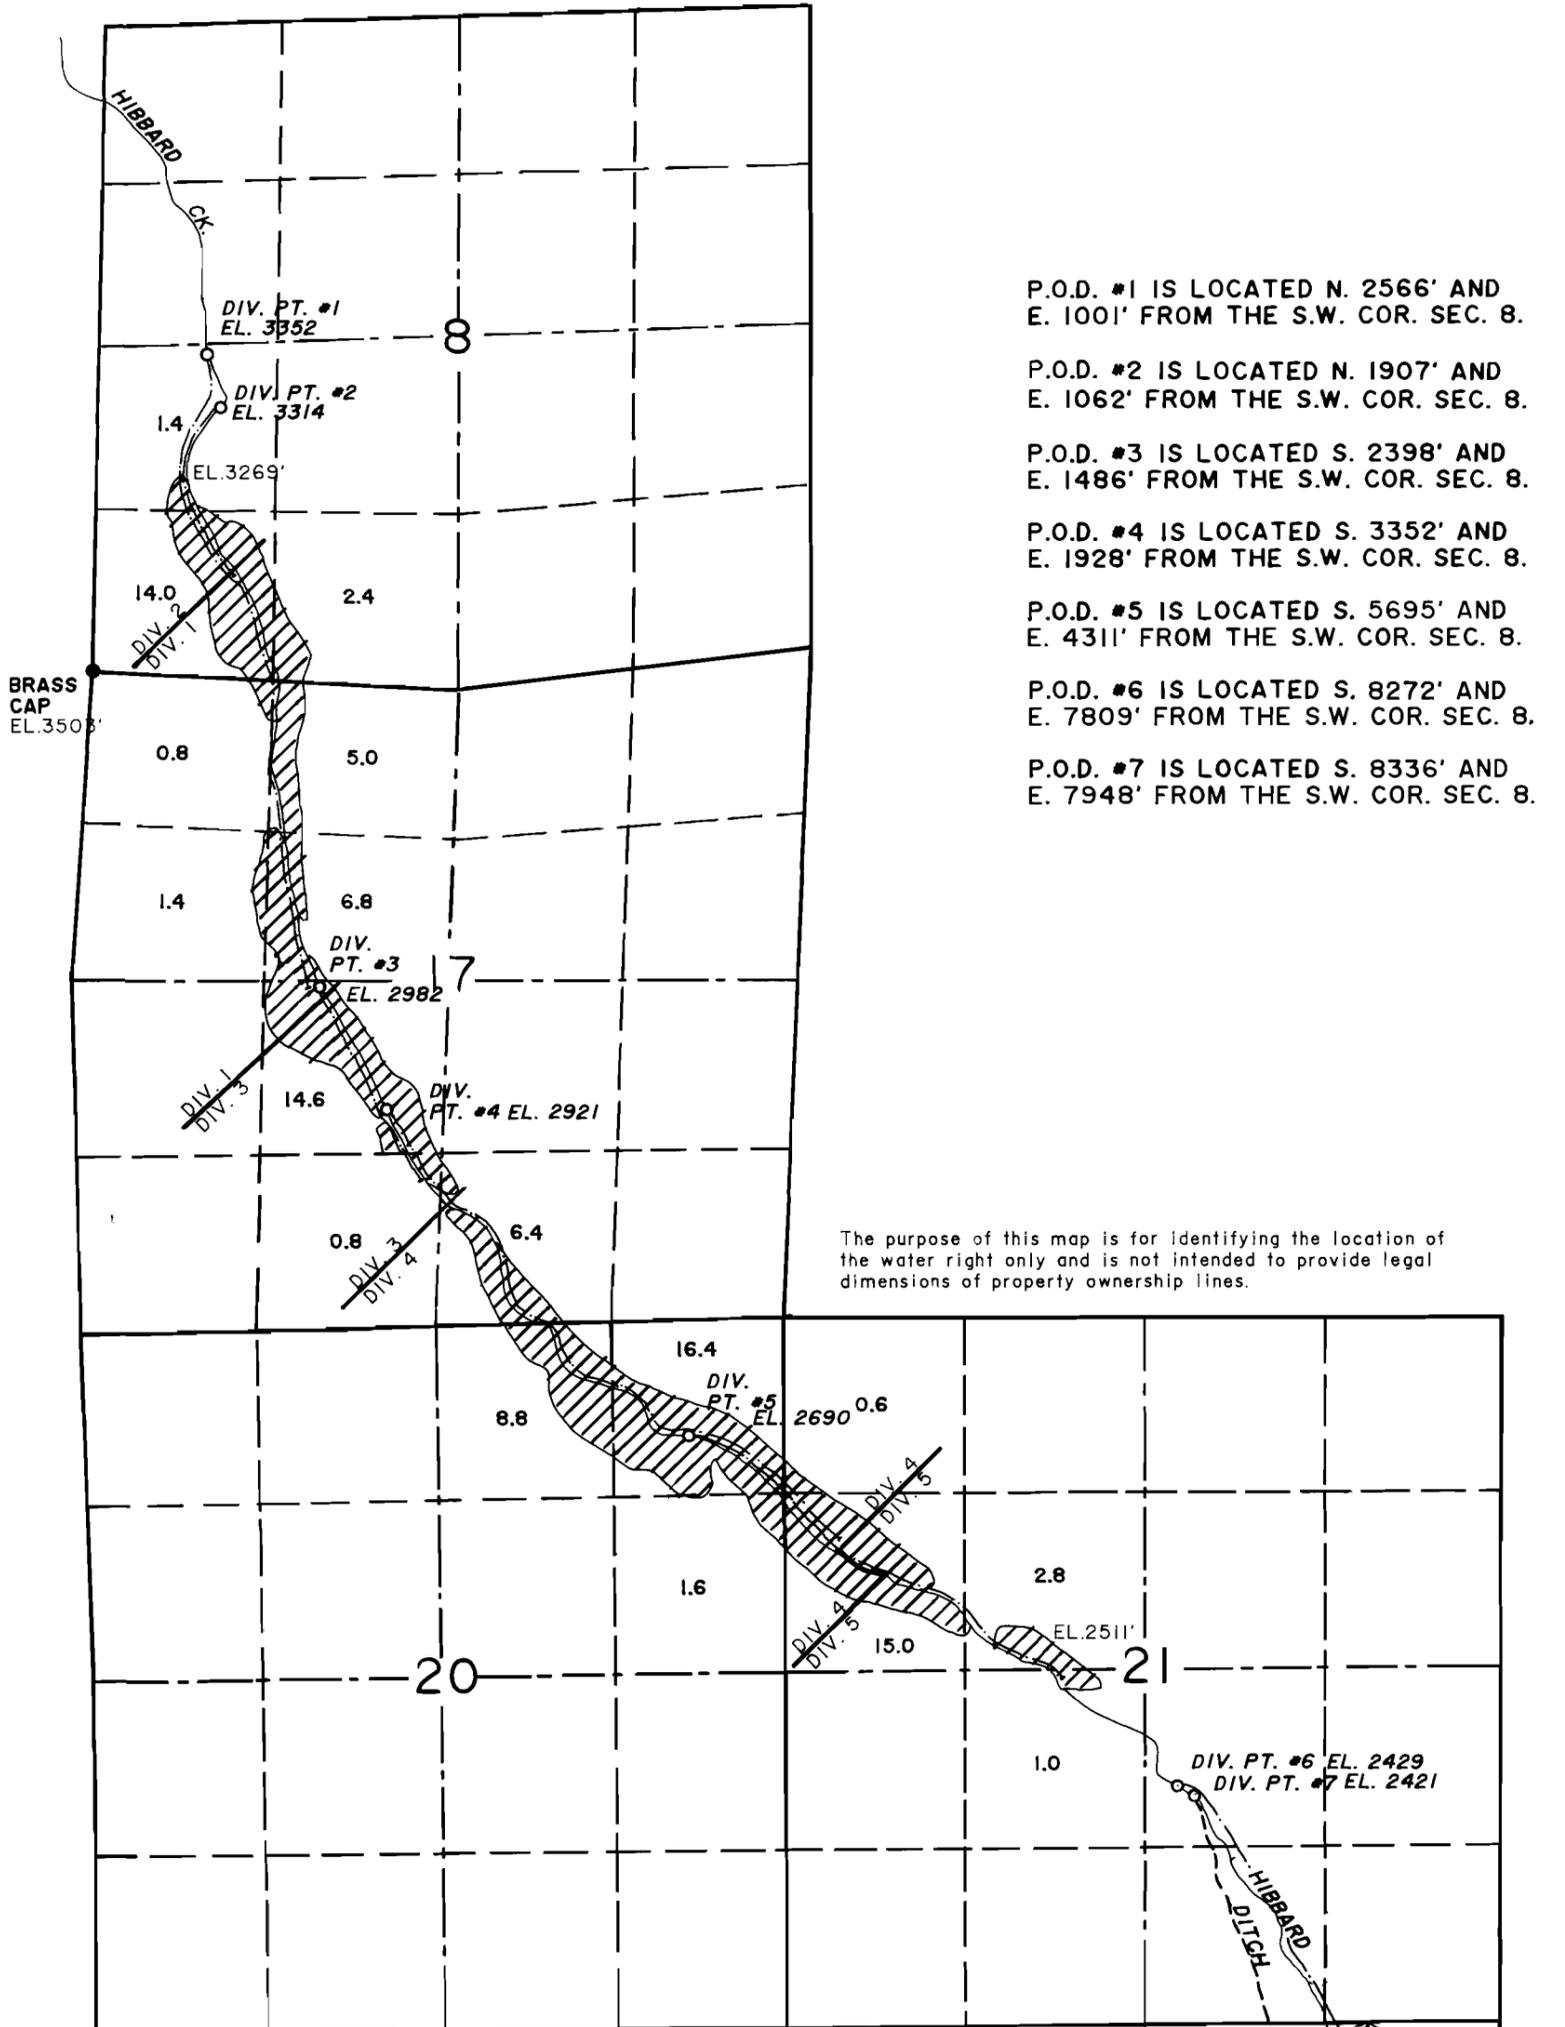


- P.O.D. #1 IS LOCATED N. 2566' AND E. 1001' FROM THE S.W. COR. SEC. 8.
- P.O.D. #2 IS LOCATED N. 1907' AND E. 1062' FROM THE S.W. COR. SEC. 8.
- P.O.D. #3 IS LOCATED S. 2398' AND E. 1486' FROM THE S.W. COR. SEC. 8.
- P.O.D. #4 IS LOCATED S. 3352' AND E. 1928' FROM THE S.W. COR. SEC. 8.
- P.O.D. #5 IS LOCATED S. 5695' AND E. 4311' FROM THE S.W. COR. SEC. 8.
- P.O.D. #6 IS LOCATED S. 8272' AND E. 7809' FROM THE S.W. COR. SEC. 8.
- P.O.D. #7 IS LOCATED S. 8336' AND E. 7948' FROM THE S.W. COR. SEC. 8.

BASIS OF ELEVATIONS: Ground at S.W. cor. Section 8 is elevation 3503.0 - U.S.G.S. Connor Creek quadrangle map, provisional issue.

PRE 1909 VESTED WATER RIGHT CLAIM MAP

-  IRRIGATED LANDS
-  DITCH
-  PIPELINE
-  HIBBARD CREEK
-  LANDS IRRIGATED FROM DIVERSION SHOWN

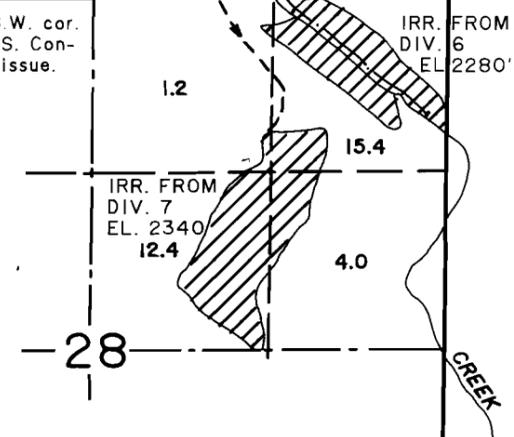

SCALE 1" = 1320'
SURVEYED OCT. 26, NOV. 3, 1993



ALEX FINKE, CLAIMANT