


RECEIVED

AUG - 5 1993

# T.5S., R.3W., W.M.

Yamhill County

WATER RESOURCES DEPT.  
SALEM, OREGON

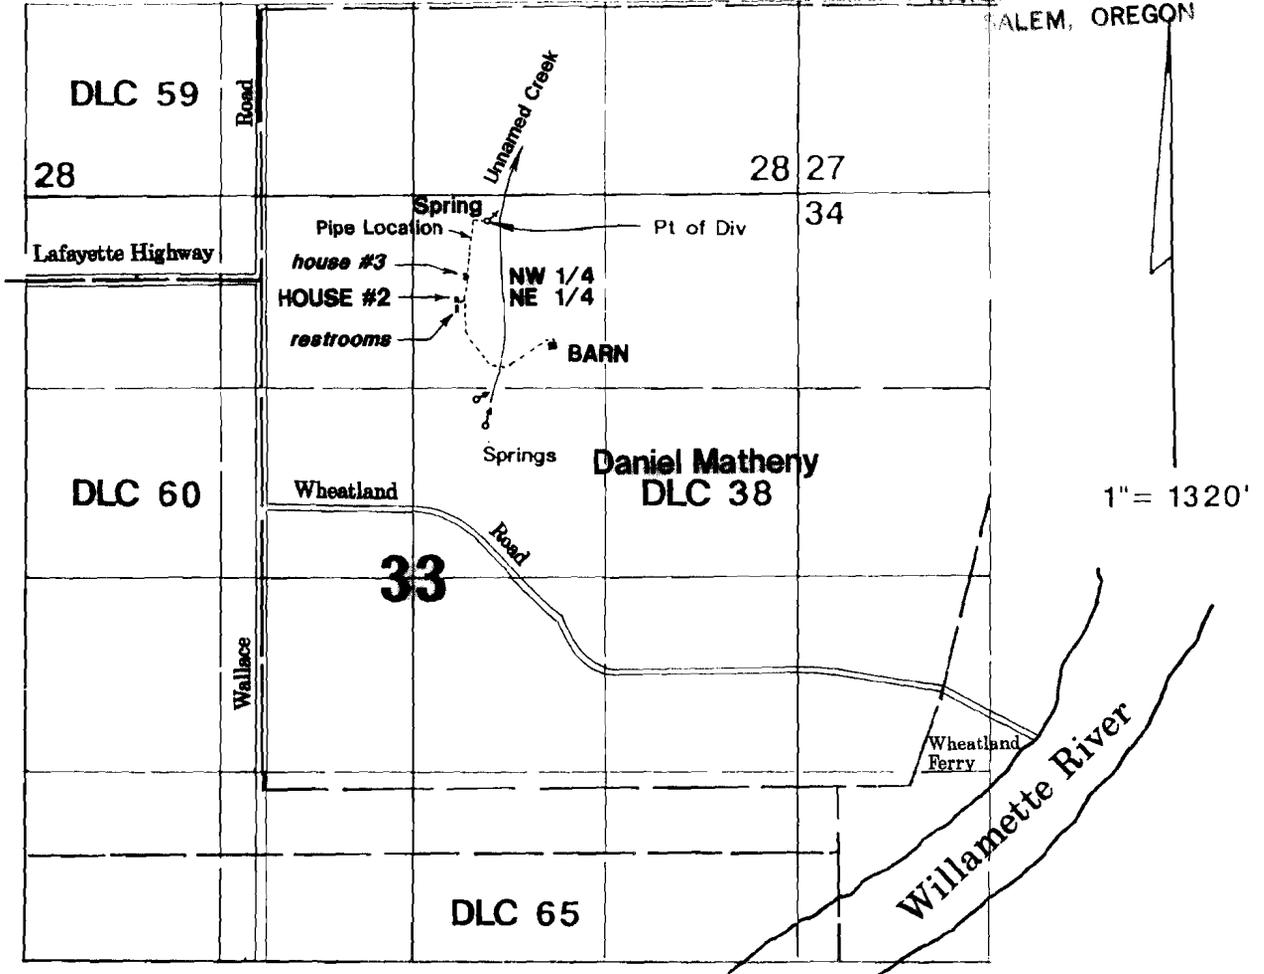

Pt of Diversion located: 400' North and 1550' East of the N.E. corner Adam Mathery DLC 60  
As projected in Daniel Mathery DLC 38 Section 33; T.5S., R.3W., W.M.

Diversion System: Two 4" dia. x 10' long PVC pipes from Spring to 24" dia. x 96" long, upright concrete pipe spring box.

NOTE: House #2 and Livestock Barn are only places of use included in this registration. Other buildings are shown for reference only.

Roy E. Smith  
Darlene S. Smith

## SURFACE WATER REGISTRATION STATEMENT PRE-1909 VESTED WATER RIGHT CLAIM

December 18, 1992

NOTE: This map is for the purpose of identifying the location of water rights and has no intent to dimension or locate property ownership lines.

