



T 12 S R 45 E W M

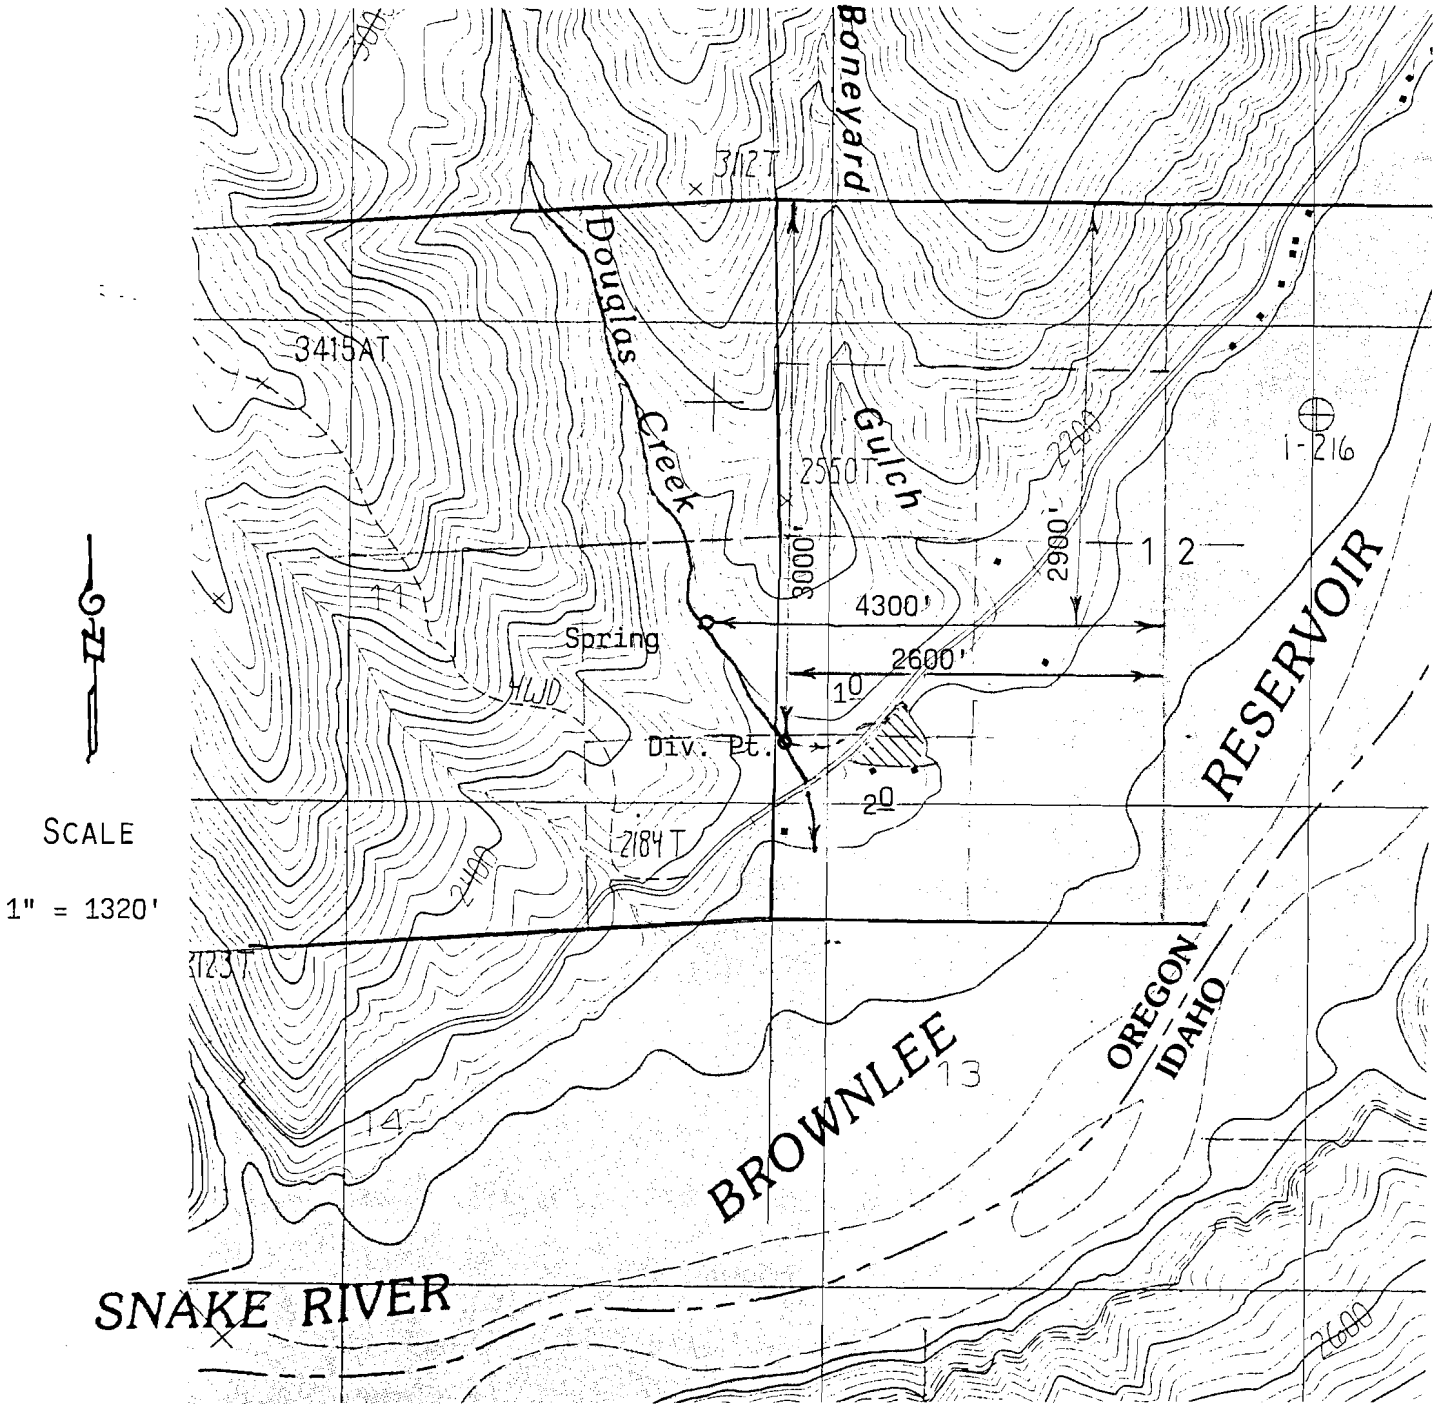

MAP TO ACCOMPANY REGISTRATION STATEMENT
PRE-1909 VESTED WATER RIGHT CLAIM

REGISTRANT
JOANN M. VALLEUR

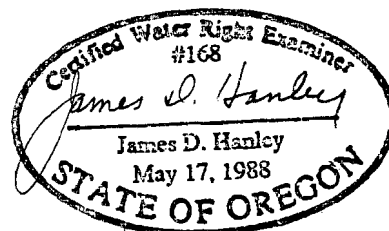

December, 1992