


T. 12 S., R. 45 E., W.M.

WATER RIGHTS DIVISION
SALEM, OREGON

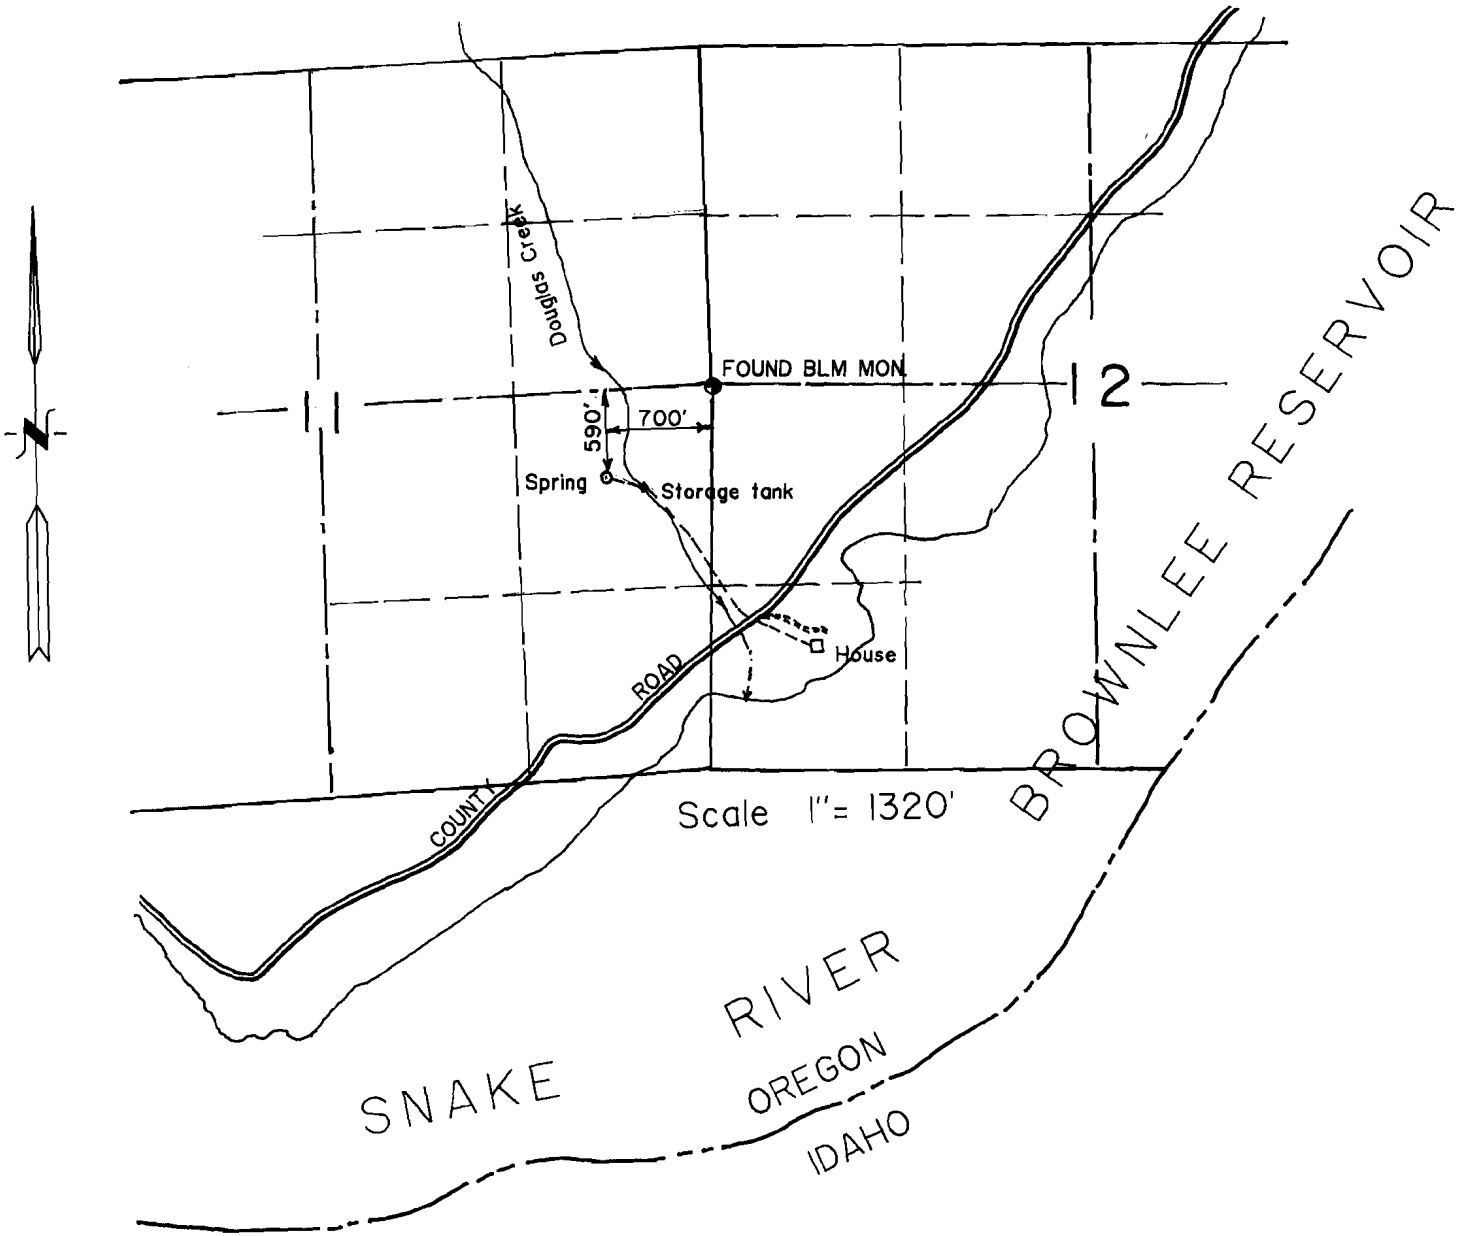

PRE-1909 VESTED WATER RIGHT CLAIM MAP

SWR-156

IN NAME OF

JOANN M. VALLEUR

Surveyed November 3, 1993 and June 10, 1994

