


REGISTRATION STATEMENT MAP
PRE-1909 VESTED WATER RIGHT CLAIM
IN THE NAME OF JOHN VERBERKMOES

RECEIVED

DEC 21 1992

SECTION 12, TOWNSHIP 28 SOUTH, RANGE 5 WEST, W.M. SALEM, OREGON
WATER RESOURCES DEPT.

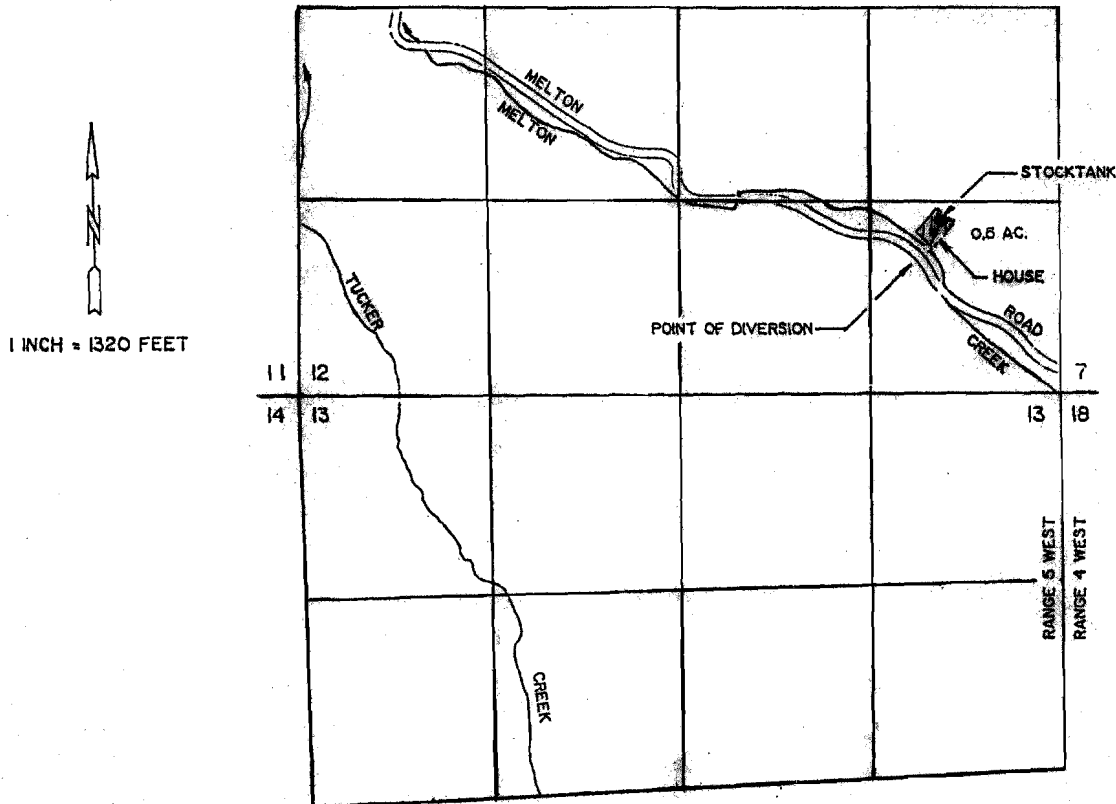

RECEIVED

OCT 01 1993

WATER RESOURCES DEPT.
SALEM, OREGON

THE POINT OF DIVERSION IS LOCATED 1000 FEET NORTH AND 920 FEET WEST FROM THE SOUTHEAST CORNER OF SECTION 12, BEING WITHIN THE SE 1/4 OF THE SE 1/4 OF SECTION 12, TOWNSHIP 28 SOUTH, RANGE 5 WEST, W.M., DOUGLAS COUNTY.

THE PURPOSE OF THIS MAP IS TO IDENTIFY THE LOCATION OF THE WATER RIGHT. IT IS NOT INTENDED TO PROVIDE INFORMATION RELATIVE TO THE LOCATION OF PROPERTY OWNERSHIP BOUNDARY LINES.

