


7-5-2013 Amendment
 Addition POD's
 Change in POU for 200.0 acres

SWR-167

REGISTRATION STATEMENT MAP
 PRE-1909 SURFACE WATER RIGHT CLAIM
 IN THE NAME OF THE ALVORD RANCH
 TOWNSHIPS 33 AND 34 SOUTH, RANGES 34 AND 35 EAST, W.M.


R 34 ↔ R 35

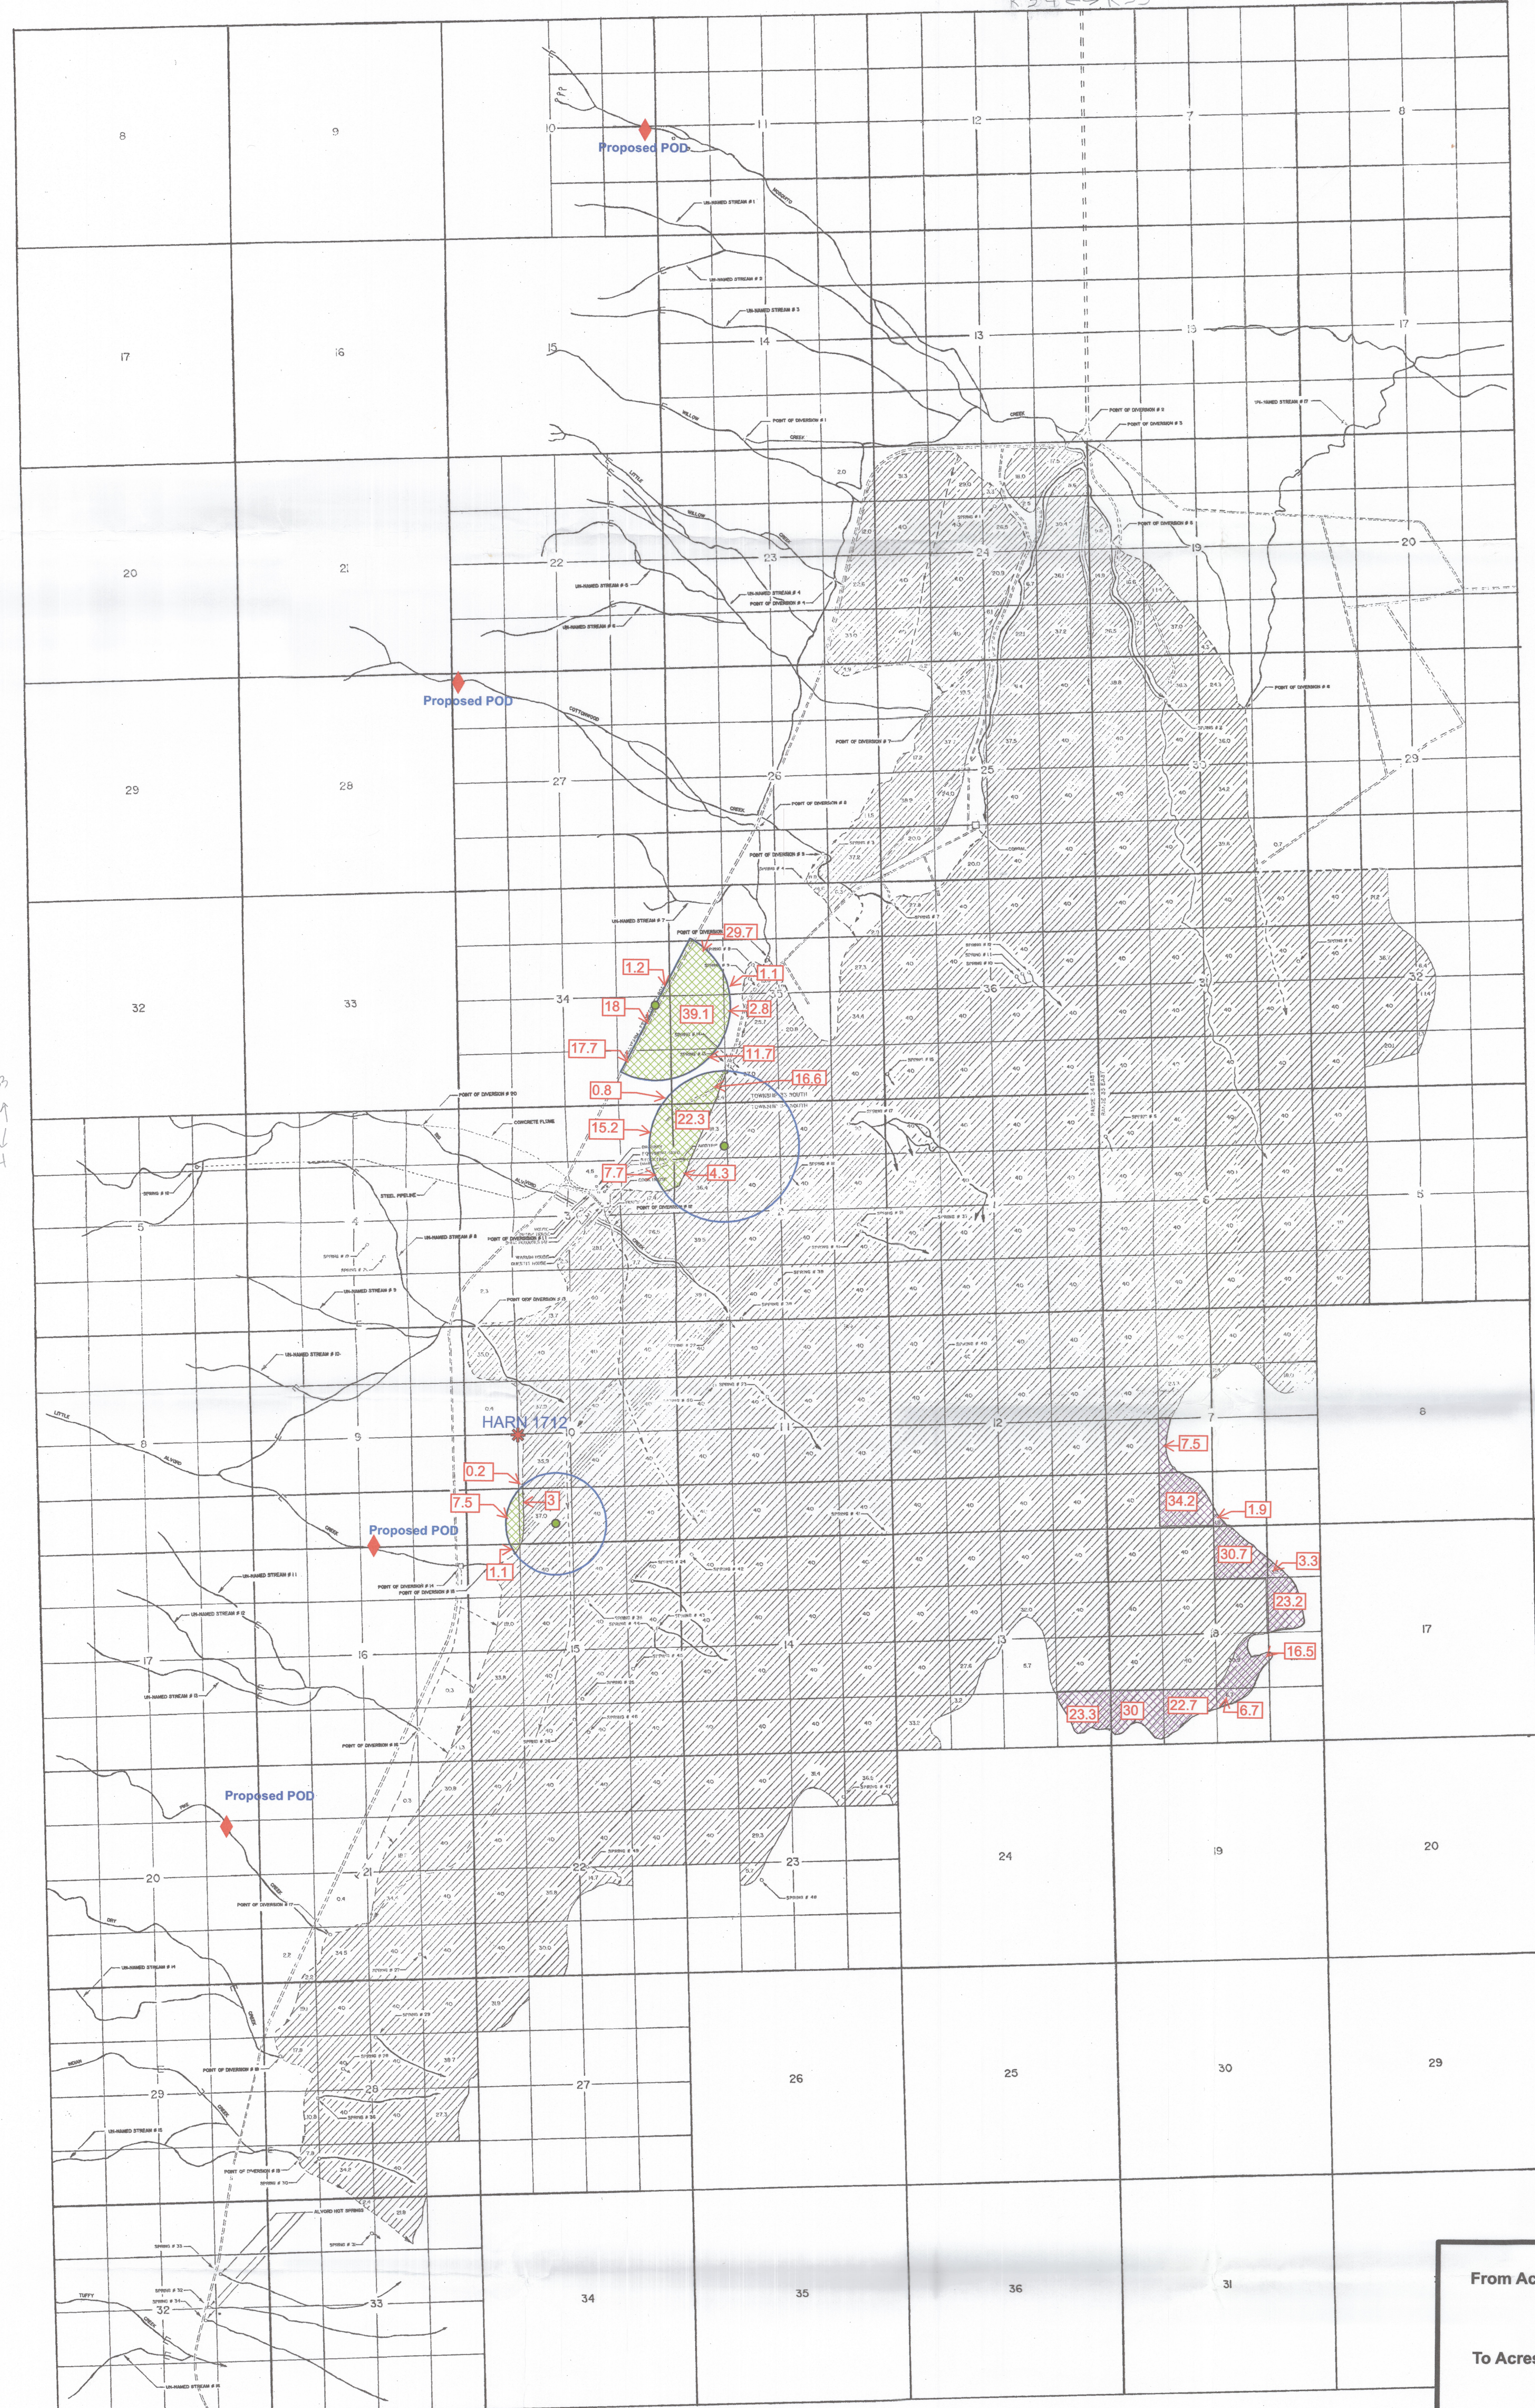

T 33
 T 34

SWR-167

DIVERSION	PT. N/S	PT. E/W	FROM	C	I	A
#1 WILLOW CREEK	8200 S	3200 W	NE COR. S. 14. R. 33. S. 35	-	-	-
#2 WILLOW CREEK	1100 S	3300 W	NE COR. S. 14. R. 33. S. 35	-	-	-
#3 MOSQUITO CREEK	4400 S	400 W	W/4 COR. S. 23. R. 33. S. 35	-	-	-
#4 LITTLE WILLOW CREEK	5200 S	3800 W	W/4 COR. S. 23. R. 33. S. 35	-	-	-
#5 LICK CREEK	5200 S	3800 W	W/4 COR. S. 23. R. 33. S. 35	-	-	-
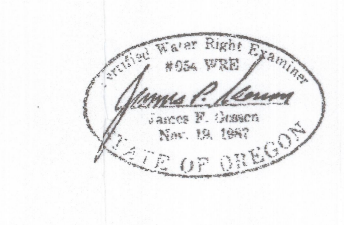

RECEIVED
 SEP 05 2013
 WATER RESOURCES DEPT
 SALEM, OREGON

From Acres 

To Acres 

Proposed PODs 

THE PURPOSE OF THIS MAP IS TO IDENTIFY THE LOCATION OF THE WATER RIGHT IF IT IS NOT INTENDED TO PROVIDE INFORMATION RELATIVE TO THE LOCATION OF PROPERTY OWNERS' BOUNDARY LINES.